



T.6S.,R.2W.,WM.

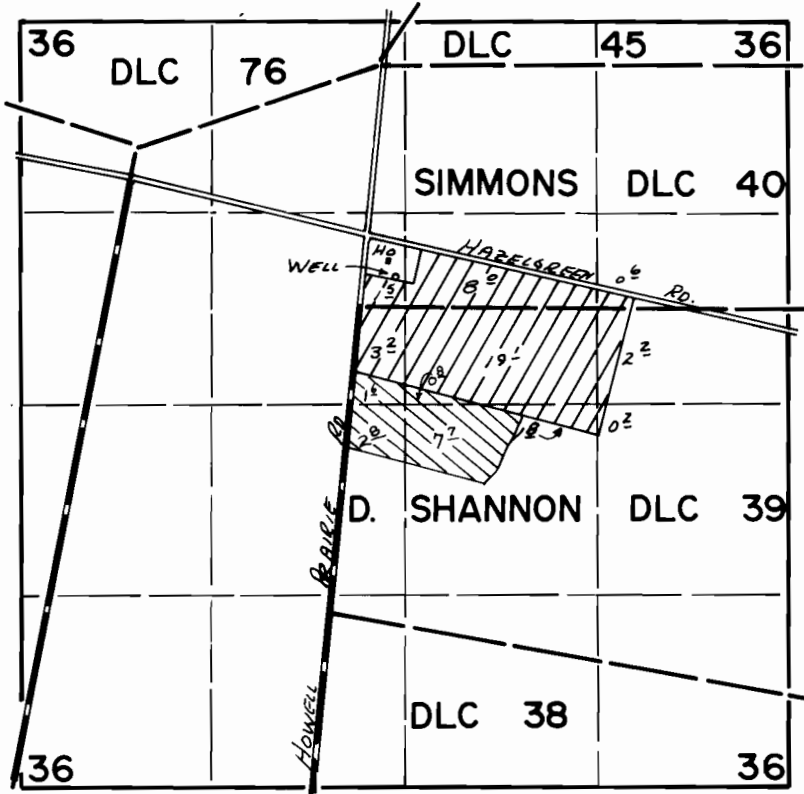

Scale: 1" = 1320'

FINAL PROOF SURVEY
UNDER

G-10286 G-9393
Application No. G-6547. Permit No. G-6152.
IN NAME OF

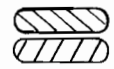

.....**ROBERT H. HARI**.....

Surveyed MAY 7, 1976, by L. TOLL
MAY 30, 1984; BEN BISHOP