


T.8S., R.1E., W.M.

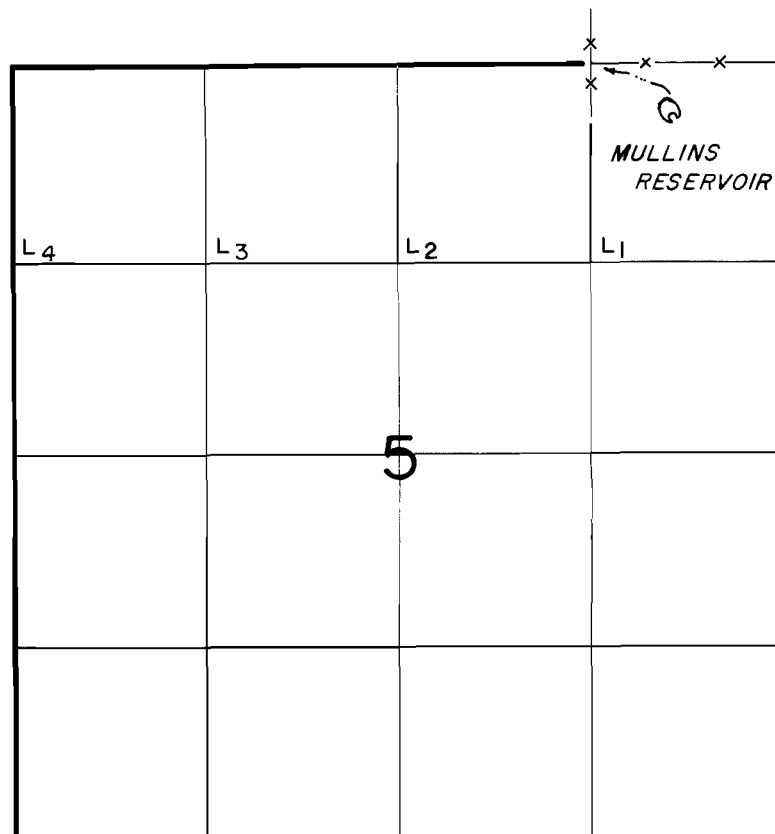

FINAL PROOF SURVEY
UNDER

Application No. R-51224 Permit No. R-6214

IN NAME OF

ROBERT MULLINS

Surveyed OCT. 2., 1979, by *Al Brown*