


T.7S., R.1W., 1E, W.M.

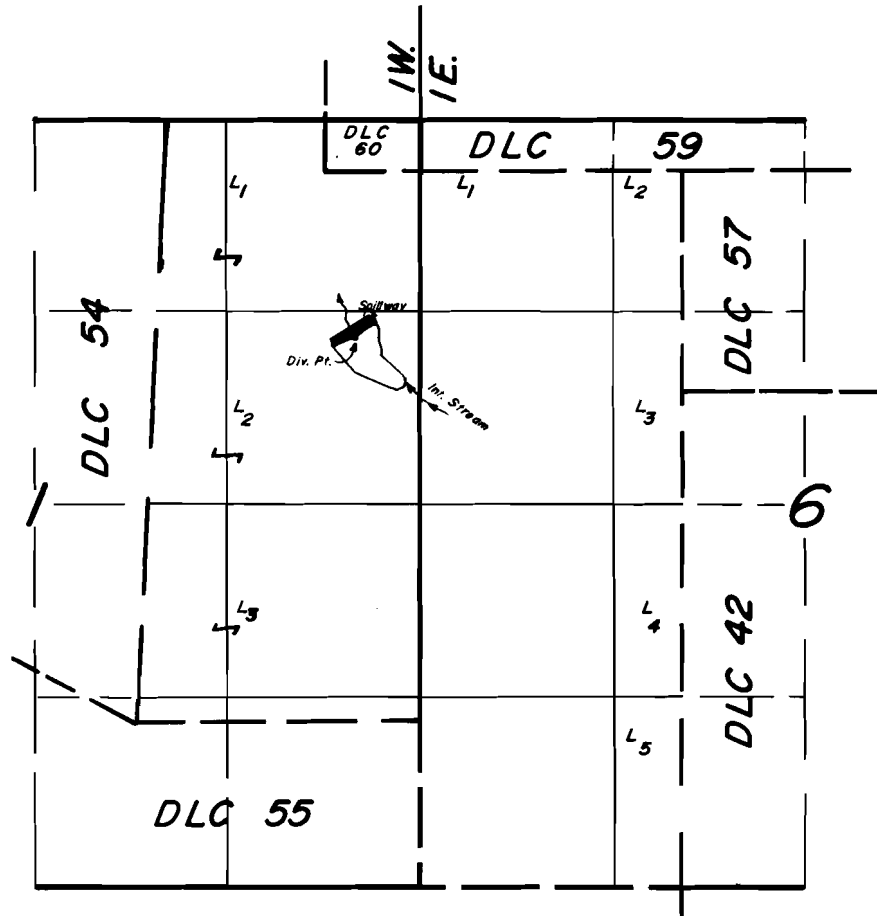

Div. Pt. Loc. : 1140' S. & 210' E. from SW Cor. DLC 60.

Scale: 1" = 1320'

FINAL PROOF SURVEY UNDER

R - 55633 R - 6577
Application No. 55634 Permit No. 41545.....
IN NAME OF

FLOYD H. PETERSEN

Surveyed MAY 31 1984, by BEN BISHOP