T.7S., R.1W., 1E.,W.M.

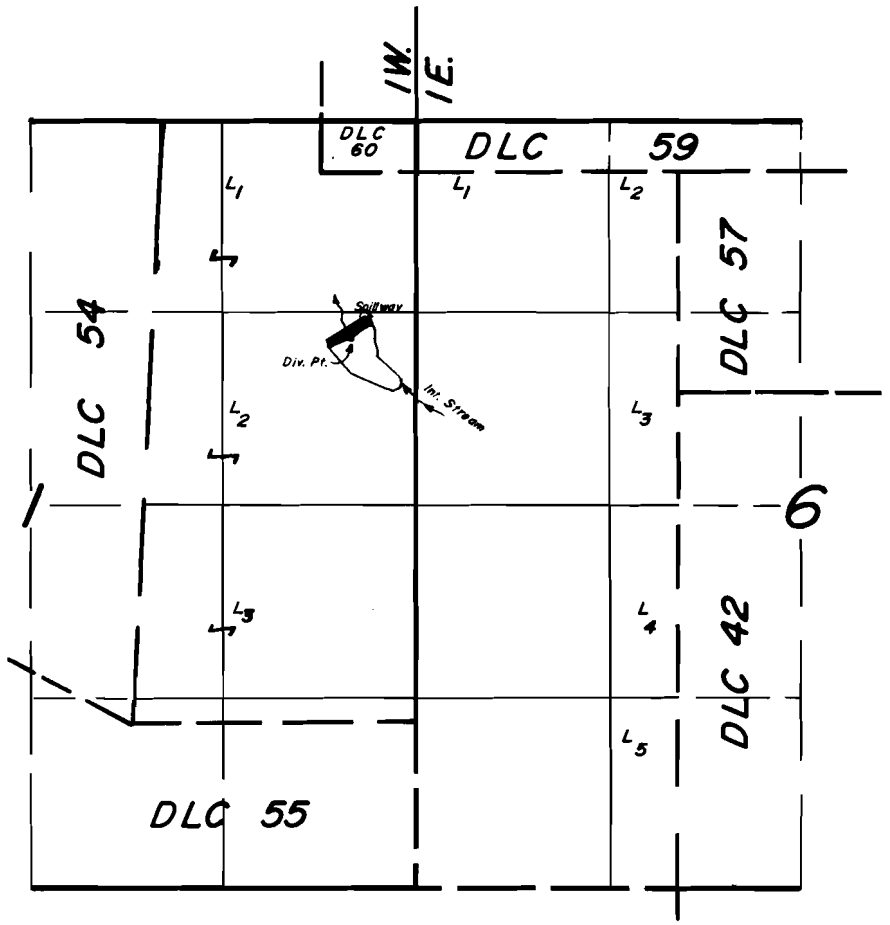

Div. Pt. Loc. : 1140' S. & 210' E. from SW Cor. DLC 60.

Scale: 1"= 1320'

FINAL PROOF SURVEY

UNDER

R-55633 R-6577

Application No. 55634 Permit No. 41545

IN NAME OF

FLOYD H. PETERSEN

Surveyed MAY 31 19 84, by BEN BISHOP

PTS-1984 L
TMW