


G-8445 5

53374

T. 4N. R. 25E. W.M.

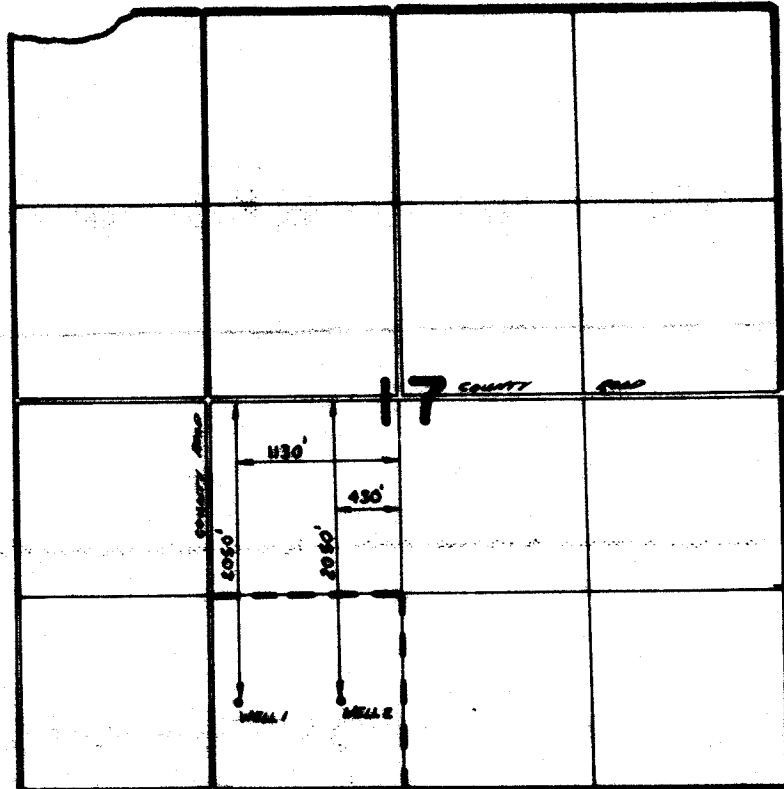

**FINAL PROOF SURVEY**  
UNDER

Application No. **G-5774** Permit No. **G-8445**  
IN NAME OF

..... **LEE E. DOCKEN** .....

Surveyed **10-12** 1972, by **K. Church** .....

272-190  
RESOLUTION