


T. 4 N. R. 25 E. W. M.

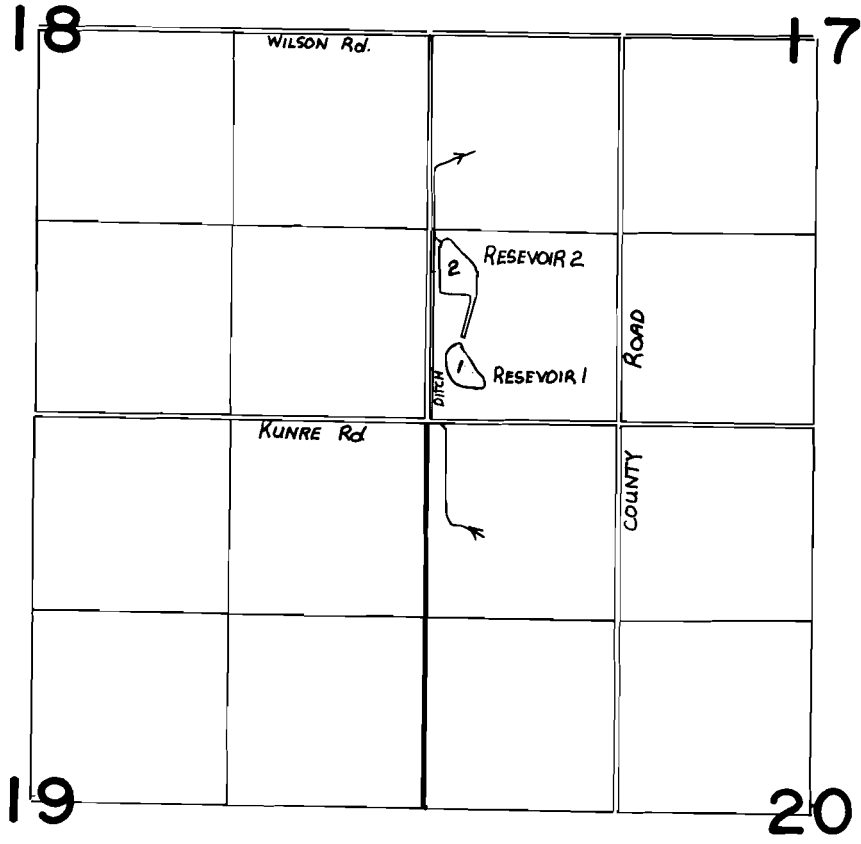

SCALE: 1"=1320'



DIV. PT. 1 LOCATED 350' N. AND 250' E. FROM SW. COR. SEC. 17
DIV. PT. 2 LOCATED 1030' N. AND 200' E. FROM SW. COR. SEC. 17

FINAL PROOF SURVEY UNDER

R-49914 R-7025
Application No. 49162.... Permit No. 42855.....

IN NAME OF

LEE E. DOCKEN

Surveyed FEB. 19. 1985., by V.L. CHURCH.....