


T. 7S. R. 3W.W.M.

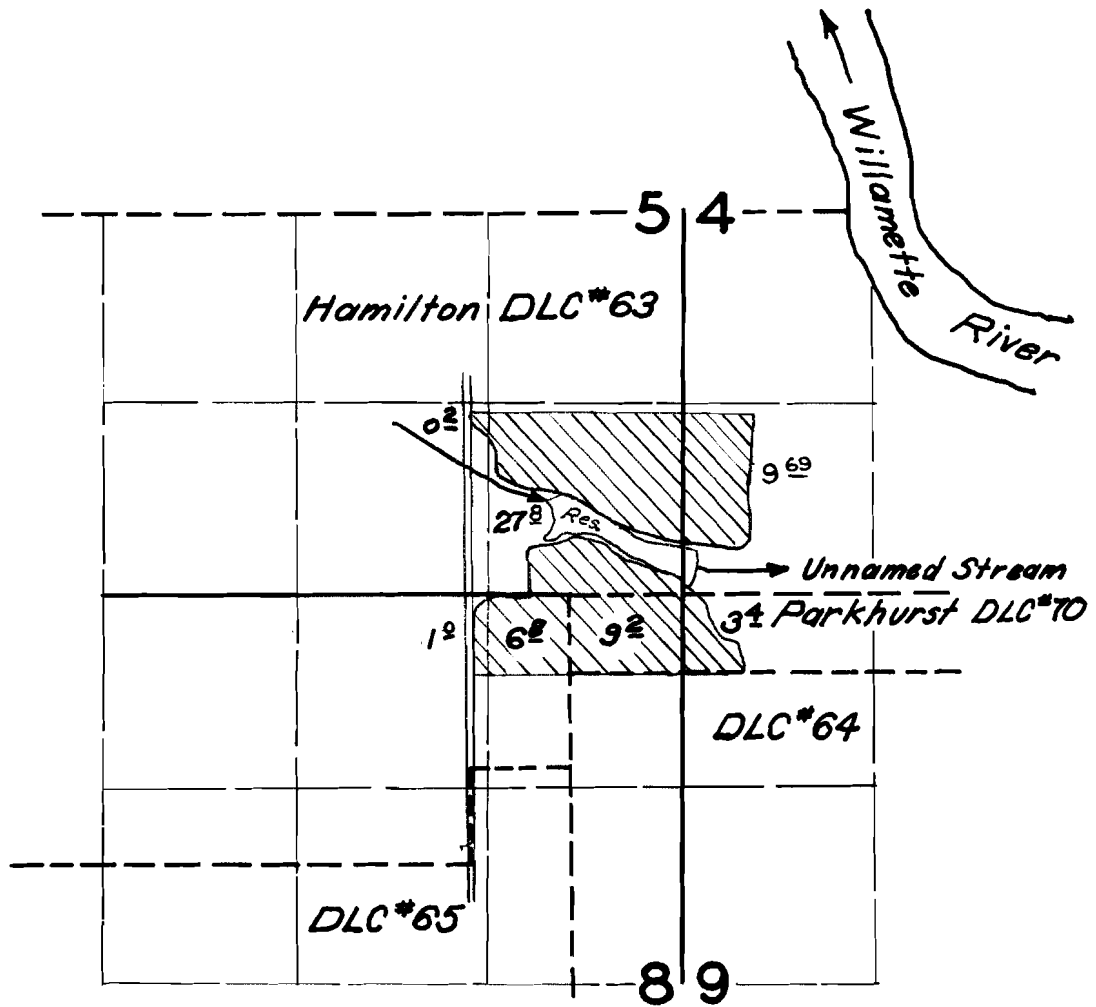

Dam Location: 160' N & 100' E from SW CORNER SECTION 4

FINAL PROOF SURVEY
UNDER

Application No. R-31073 / 31074 Permit No. R-2002 / 24780
IN NAME OF

MARK GEHRING

Surveyed 25 July, 1962, by Carl R. Baker