


T.6S.R.4W.W.M.

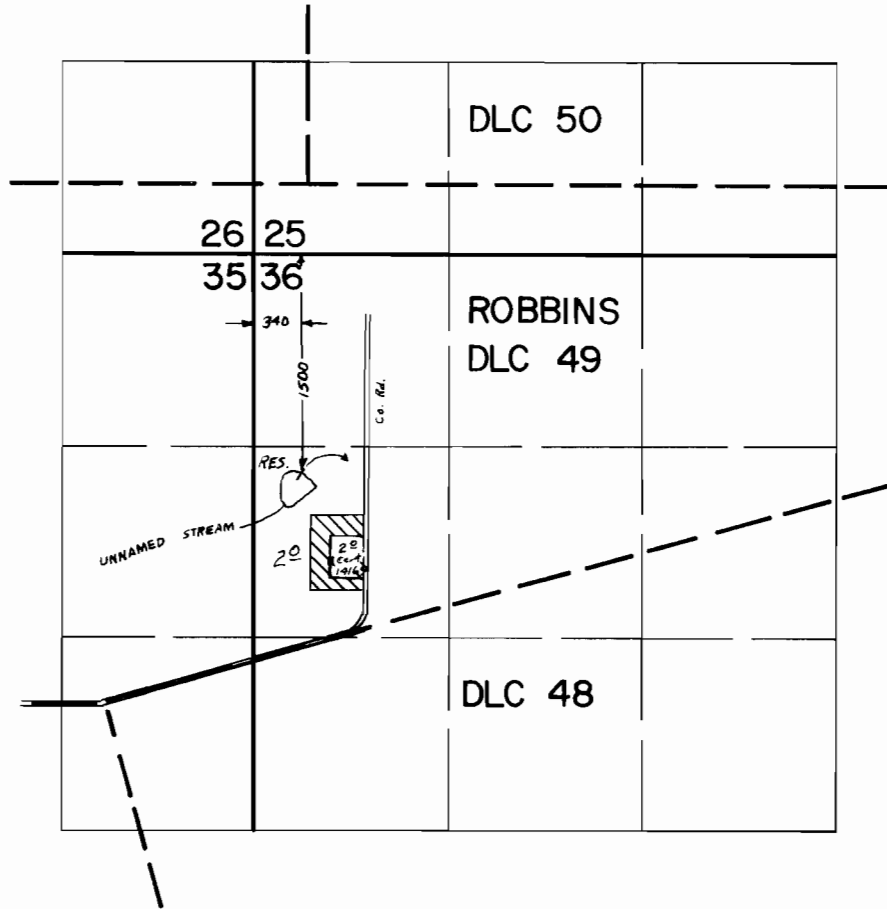

FINAL PROOF SURVEY UNDER

Application No. R-47170 47171 Permit No. R-5664 35313
IN NAME OF

P. H. BRYDON

Surveyed NOV 7 1972, by L. GOULD