


T.6S., R.3W., W.M.

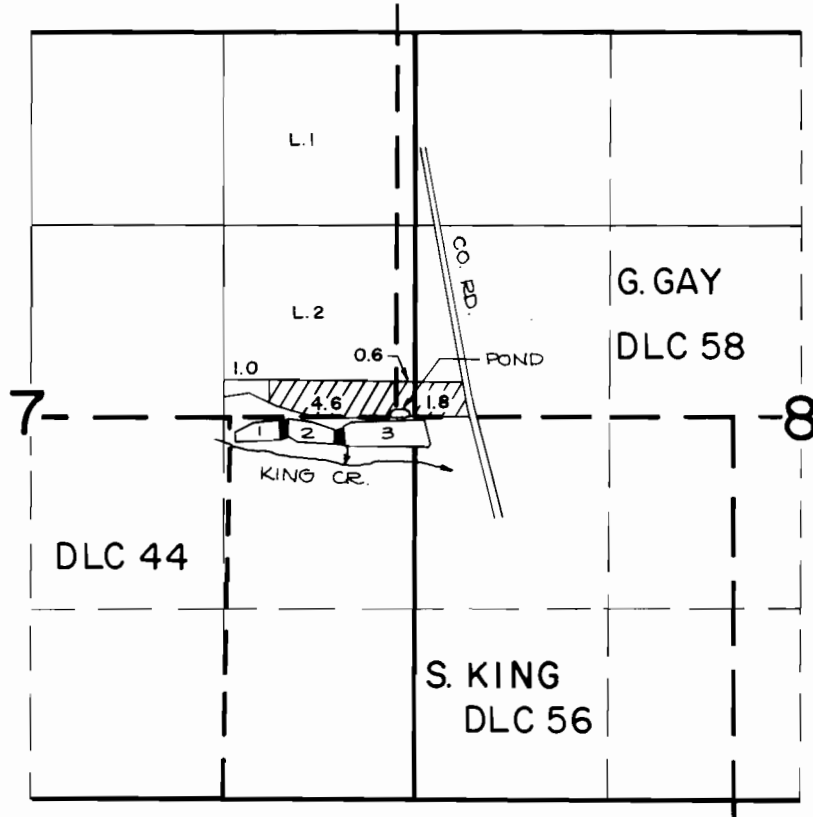

DAM #3 LOCATION: 120 FT. S. AND 1000 FT. E. FROM THE N.W. CORNER OF THE S. KING DLC 56.

FINAL PROOF SURVEY
UNDER

SCALE: 4" = 1 MILE

Application No. 5.2.9.1.2.. Permit No. 3.9.9.5.7.....
IN NAME OF

.....DUANE.....I.....CASE.....

Surveyed OCT. 2, 1984, by P. Patten.....
MAY 16, 1979 C. HUGHES