


T. 9 S., R. 6 W., W.M.

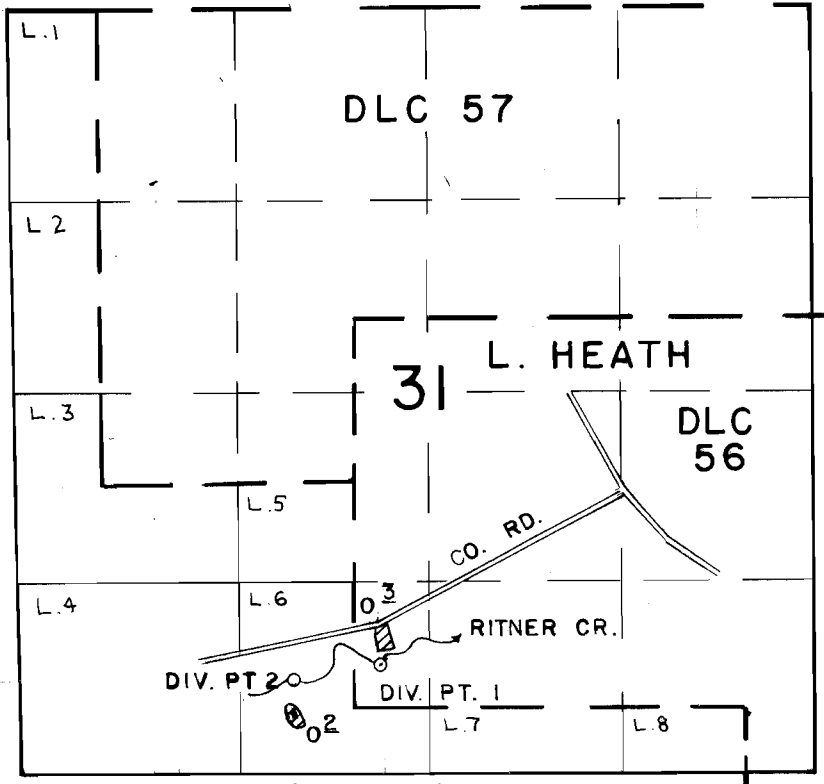

DIV. PT. LOC. 1 300' N & 190' E.
2. 200' N. & 410' W.
FROM MOST WESTERLY SW COR. DLC 56

FINAL PROOF SURVEY UNDER

Application No. 53786 Permit No. 40386
IN NAME OF

ANGUS M. & ROBERTA T. MOORE

Surveyed AUG 6 1984, by L. TOLL