


T.1&2S.R.7&8W.W.M.

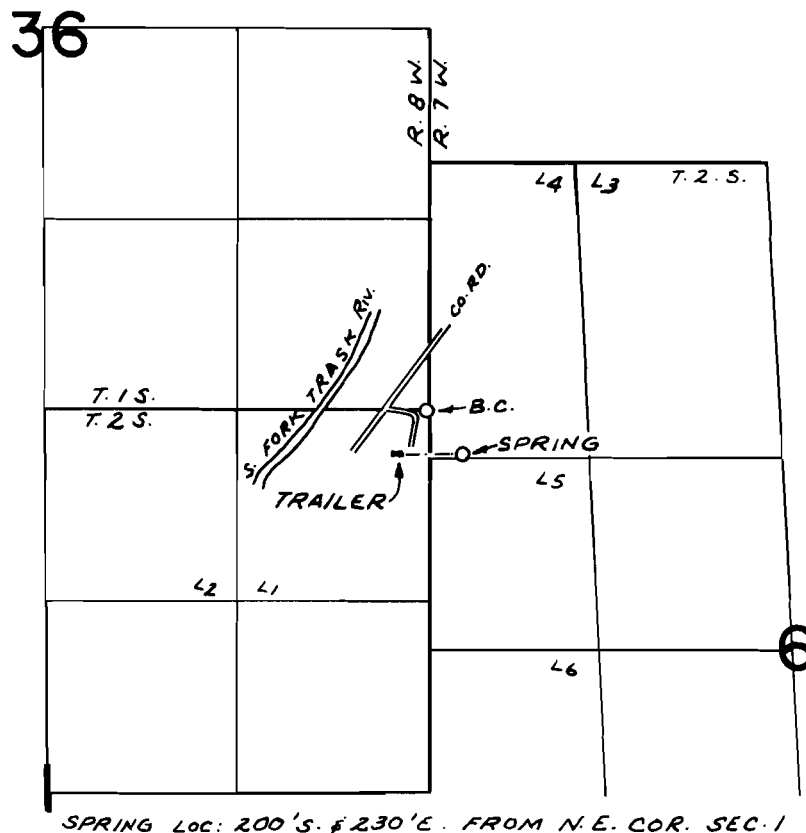

FINAL PROOF SURVEY
UNDER

Application No. 47315 Permit No. 35448
IN NAME OF

JERRY & GLEN GRIMMETT

Surveyed MAY 10 1978, by S. DONALDSON
FEB. 13, 1980 R.G. MUCKEN