
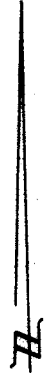


G 6791 5
53388

T. 5N., R. 29E., W. M.

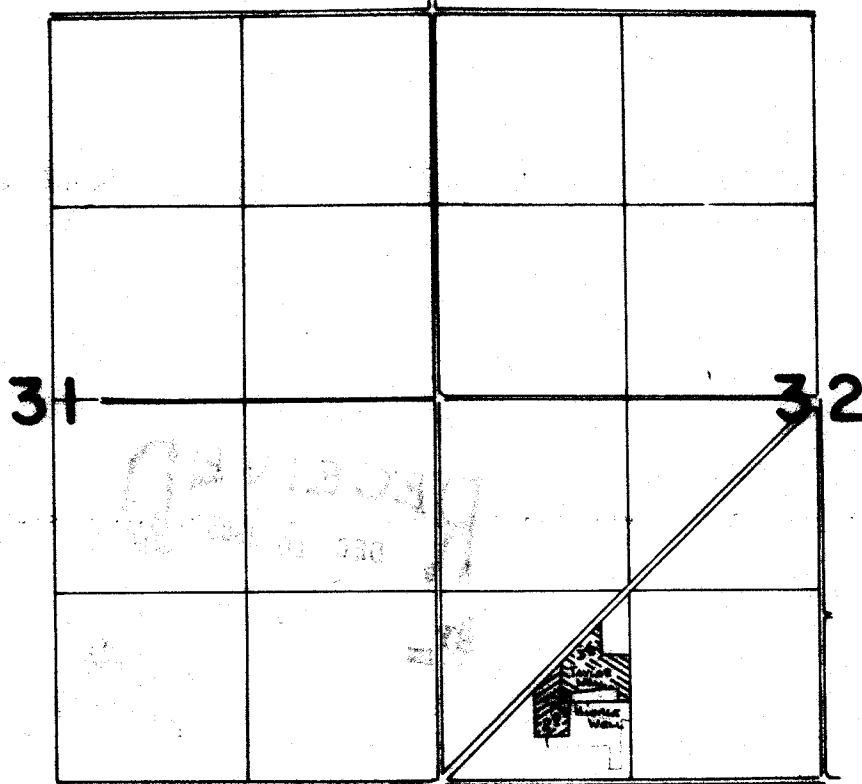

SCALE 1"=1320'

HINKLE WELL LOCATED 490' N. & 870' E. FROM SW COR. SEC. 32
TAYLOR WELL LOCATED 600' N. & 870' E. FROM SW COR. SEC. 32

FINAL PROOF SURVEY
UNDER

Application No. G: 6424 Permit No. G: 6791....
IN NAME OF

CURTIS E. HINKLE & JERRY TAYLOR

Surveyed July 16, 1984, by V.L. Clark

Curt. 53388