


G-7974 5  
53390

# T. 1S. R. 32E. W.M

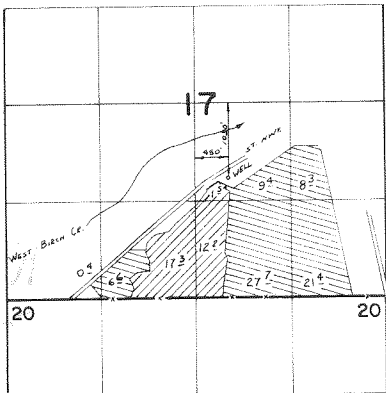

PRIMARY



SUPPLEMENTAL

## FINAL PROOF SURVEY UNDER

Application No. G-8618 Permit No. G-7974  
IN NAME OF

RALPH J. & ANITA M. HUTCHISON..

Surveyed ..2-15..... 1979.. by R. BARWILL.....