


T. 4N., R. 29E., W. M.

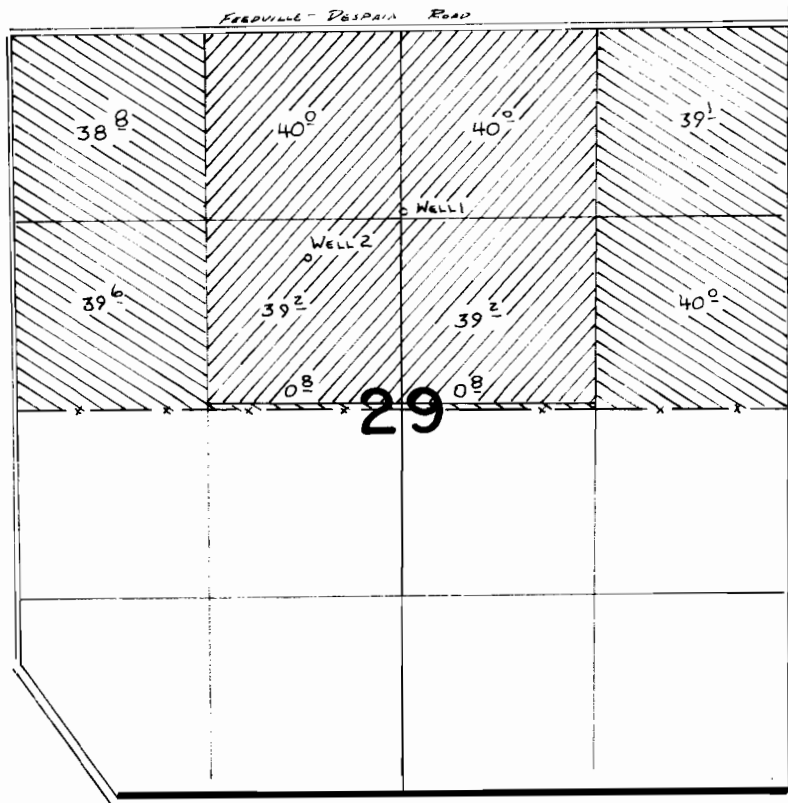

SCALE: 1" = 1320'

WELL 2 LOCATED 1050' N. & 640' W. FROM CENTER COR. SEC 29



PRIMARY



SUPPLEMENTAL

FINAL PROOF SURVEY
UNDER

Application No. **G:6654** Permit No. **G:8036**
IN NAME OF

LOYALTA, INC.

Surveyed **7:21** 19**78**, by **R. Berwin**