


T. 2N., R. 33E., W. M.

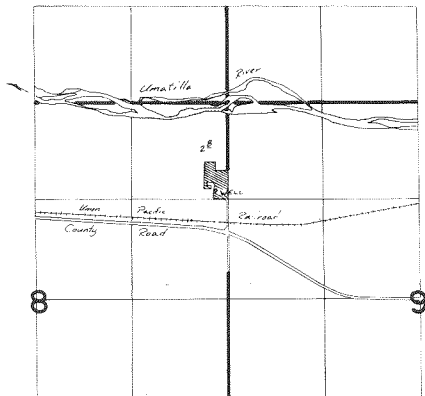

Well located 1200' S x 160' W FROM NE Cor. Sec. 8

FINAL PROOF SURVEY

UNDER

Application No. G:8917 Permit No. G:8355
 IN NAME OF

PAUL CHRISTENSEN

Surveyed May 19 1925, by R. L. Church