


T. 2N. R. 30E. W.M.

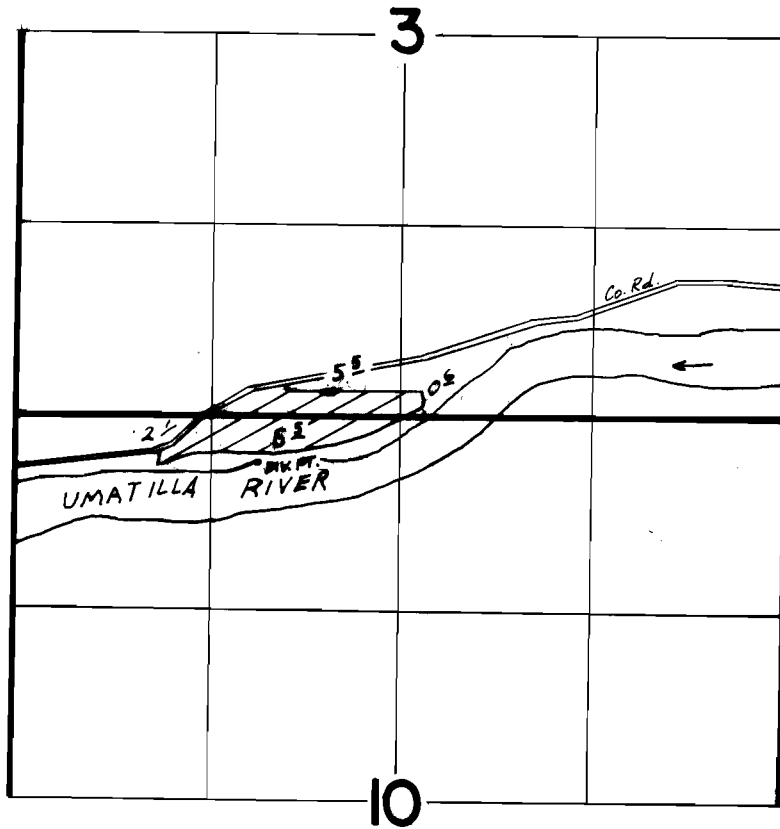

DIV. PT. LOCATED 340'S & 970'W FROM N1/4 COR OF SEC 10

**FINAL PROOF SURVEY**  
UNDER

Application No. 56951 Permit No. 42786  
IN NAME OF

**MRS. E. MARGARETT SKILLMAN**

Surveyed 7-25 1978, by R. BARWIN