


T. 3N., R. 33E., W. M.

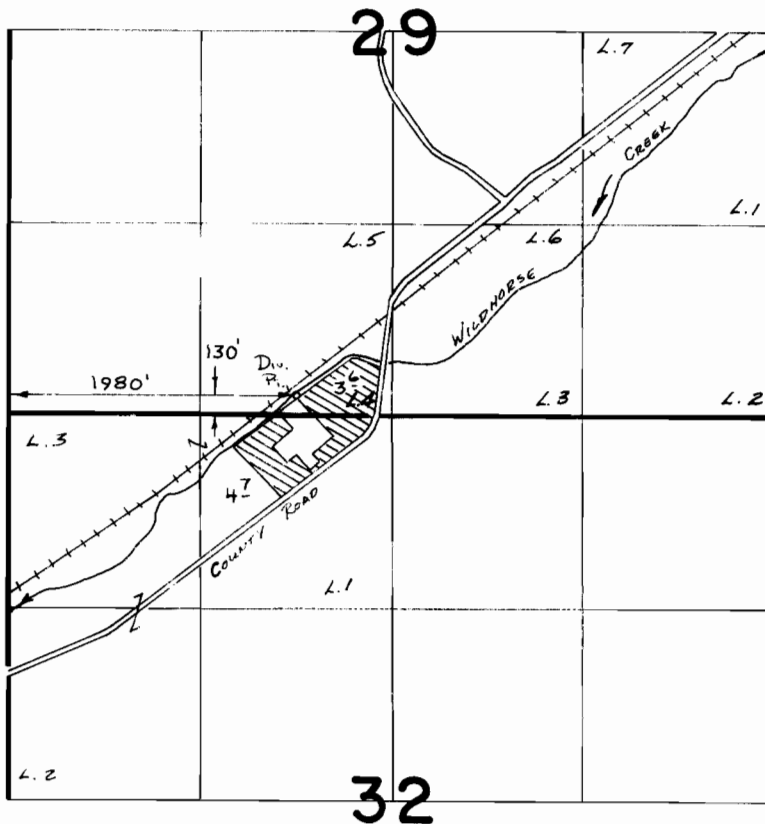

FINAL PROOF SURVEY
UNDER

SCALE: 1" = 1320'

Application No. **57433** Permit No. **43255**
IN NAME OF

MONROE BYFORD

Surveyed Jan. 23, 1979, by R. BARNETT