


T.2S., R.45E., W. M.

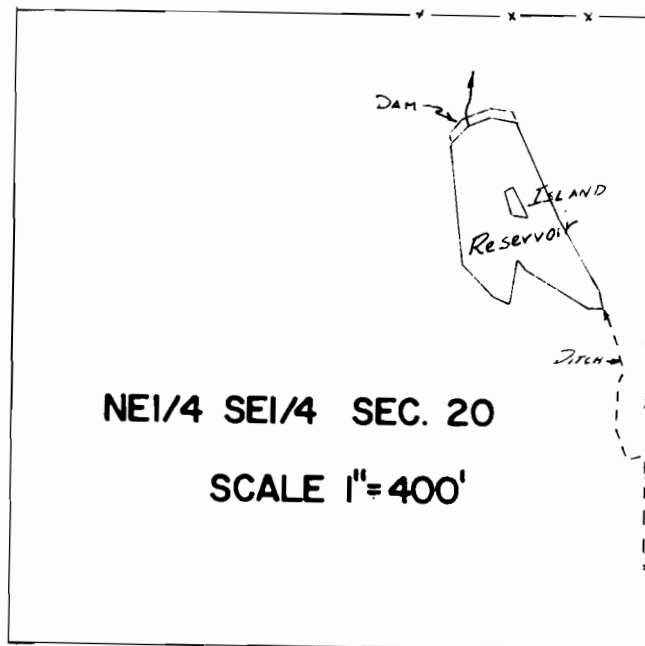

WRENN DOBBIN DITCH Div. Pt. FROM WALLOWA RIVER LOC: 550'S
± 800' W. FROM NE COR. SEC 31

FINAL PROOF SURVEY

UNDER

R-49137

R-5980

Application No. 49138 Permit No. 36845

IN NAME OF

DAVID D. B. MARVEENE A. DUMMER

Surveyed 8-22 1978, by R. BARWIN