


T. 1 N., R. 43 E., W.M.

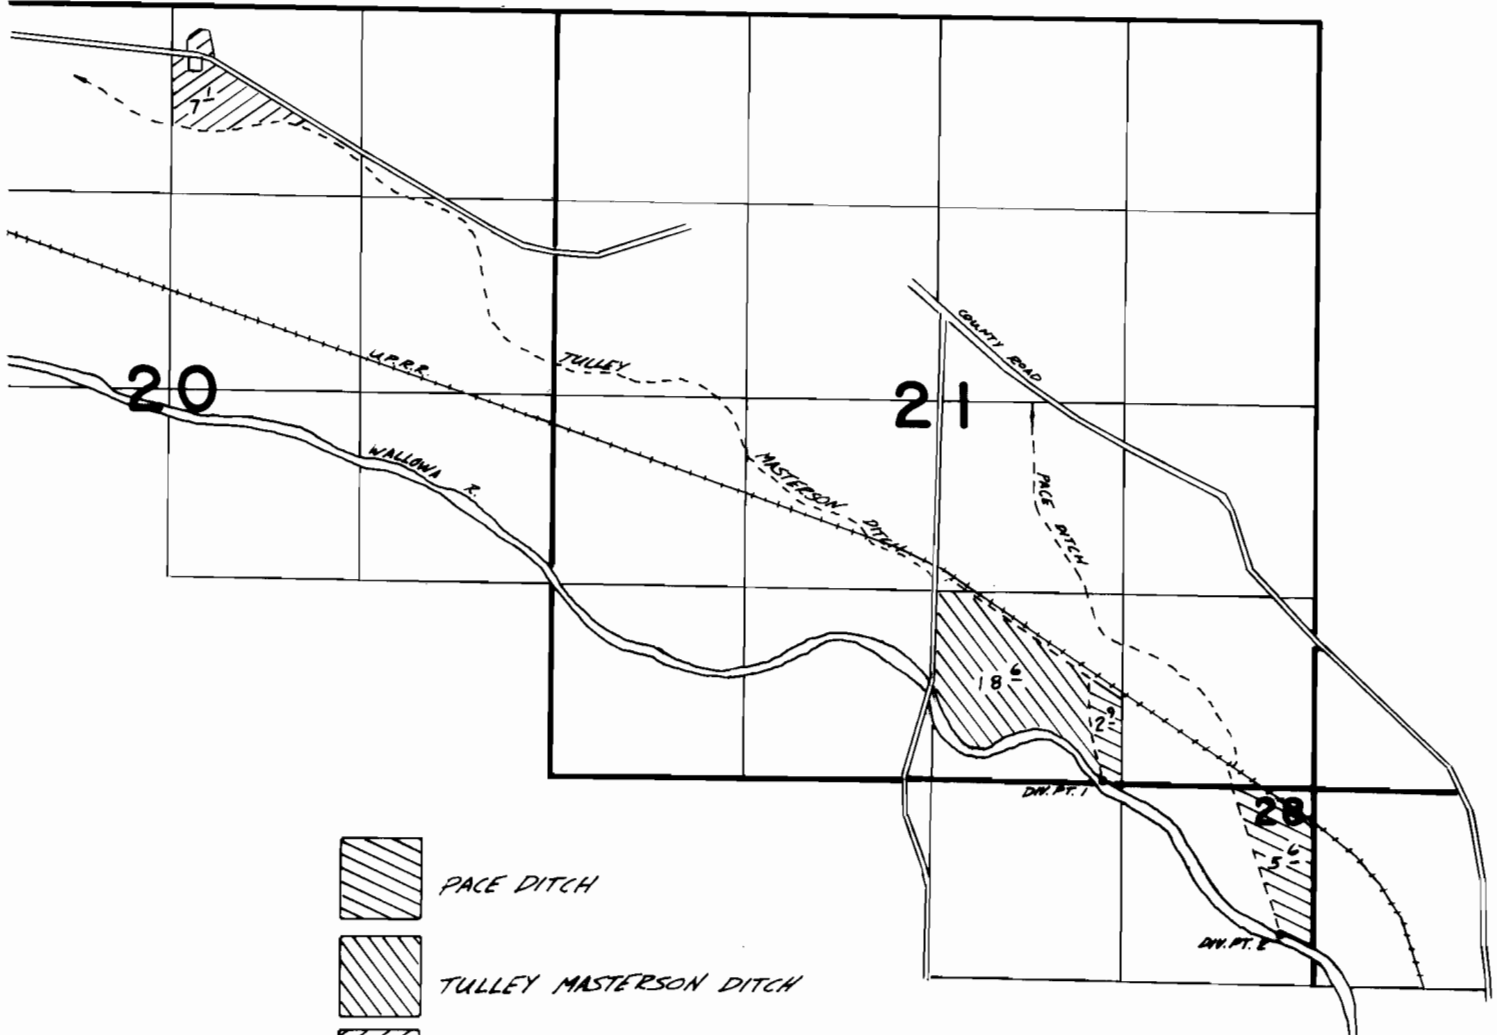

-  PACE DITCH
-  TULLEY MASTERSON DITCH
-  ALUMBAUGH DITCH

DIV. PT. 1 LOC. 20'N & 1170'E FROM 1/4 COR. SEC. 21
DIV. PT. 2 LOC. 1000'S & 220'W FROM NE COR SEC 28

FINAL PROOF SURVEY UNDER

APPL. 46552 PERMIT 34778
IN NAME OF

D.G. IMSLAND & DONNA IMSLAND

SURVEYED 8-29-1978, by R. BARWIN

