


# T. 3 S., R. 3 W., W.M.

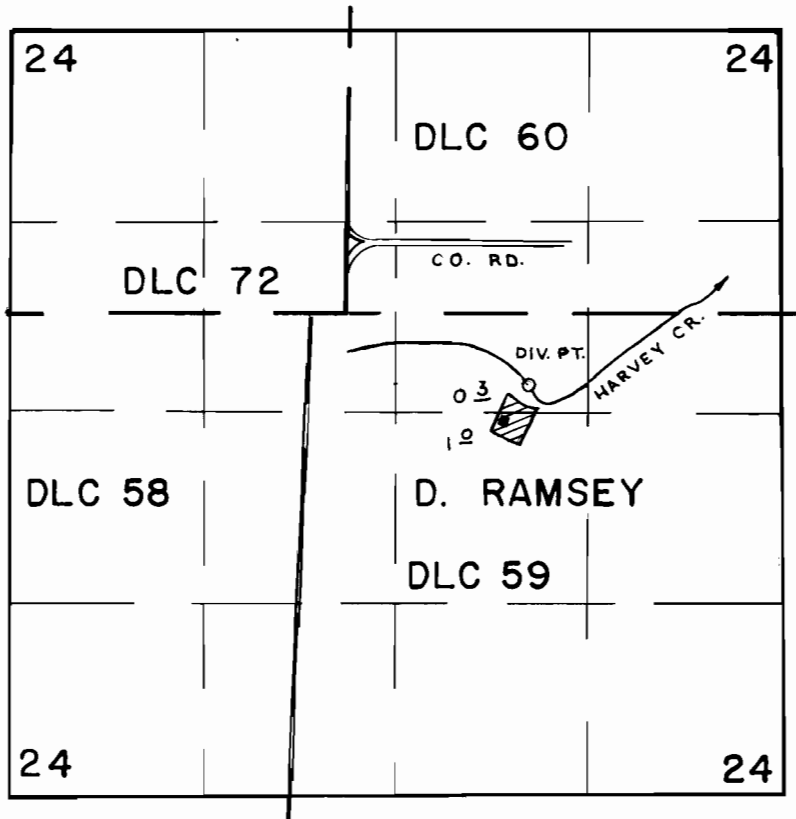

DIV. PT. LOC. 490' S. & 1490' E. OF NW COR. DLC 59

## FINAL PROOF SURVEY UNDER

Application No. 51491 Permit No. 38864  
IN NAME OF

EDMUND & LEONA KOTH

Surveyed JUL 2 1984, by P. PAGTER