


T.5S., R.3W., W.M.

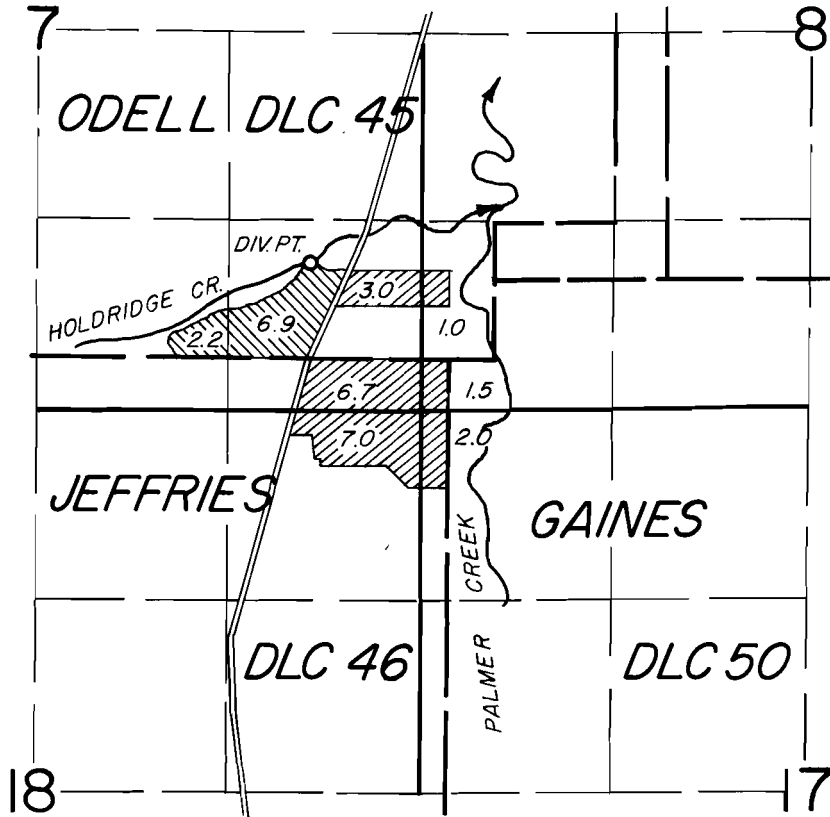

DIV. PT. LOC.: 660' N. & 960' W. from the NE Corner DLC 46

 PRIMARY

 SUPPLEMENTAL

FINAL PROOF SURVEY UNDER

Application No. 53040 Permit No. 40028.....

IN NAME OF

MICHAEL CARR

Surveyed MAY 9 a. 1979, by C. RODRIGUEZ.....