


T.2S., R.5W., W.M.

SECTION 34

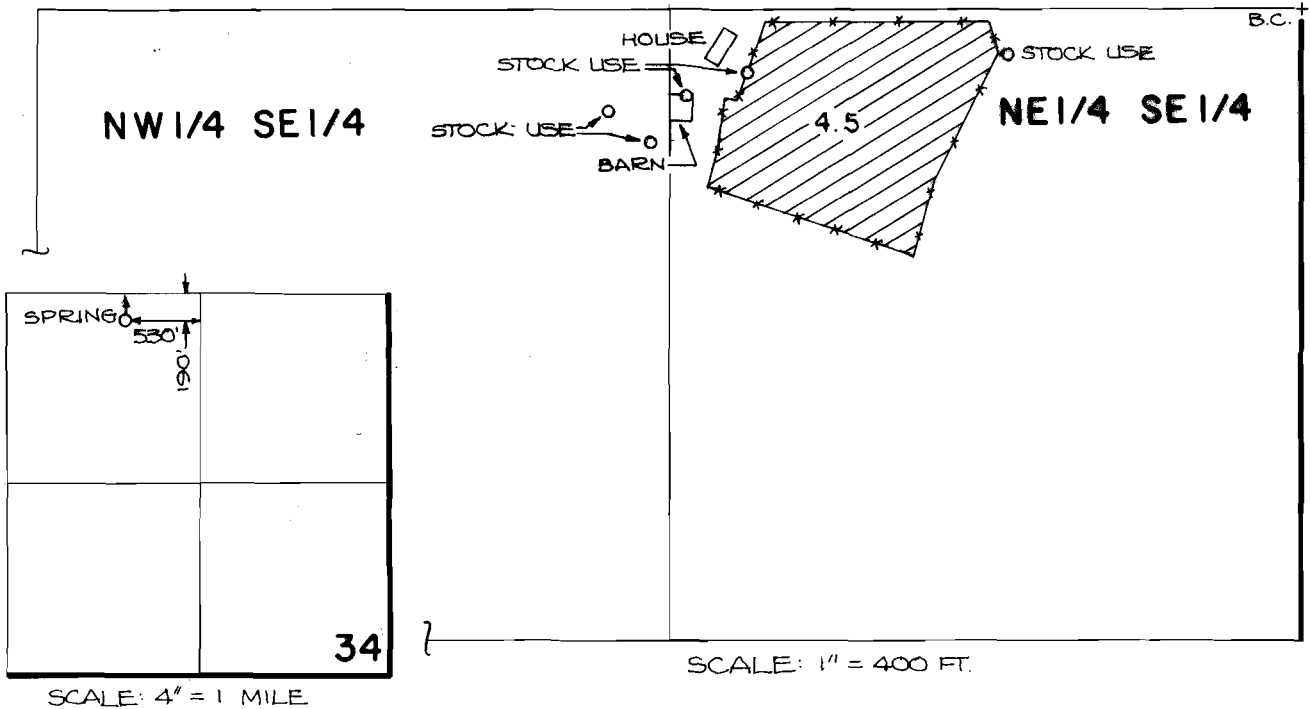

FINAL PROOF SURVEY
UNDER

Application No. 60997 Permit No. 45456.....
IN NAME OF

FRANK L. & EVAMAE C. GEELAN

Surveyed SEPT. 20, 1984, by P. Patten.....