


T. 2S., R. 4&5E., W. M.

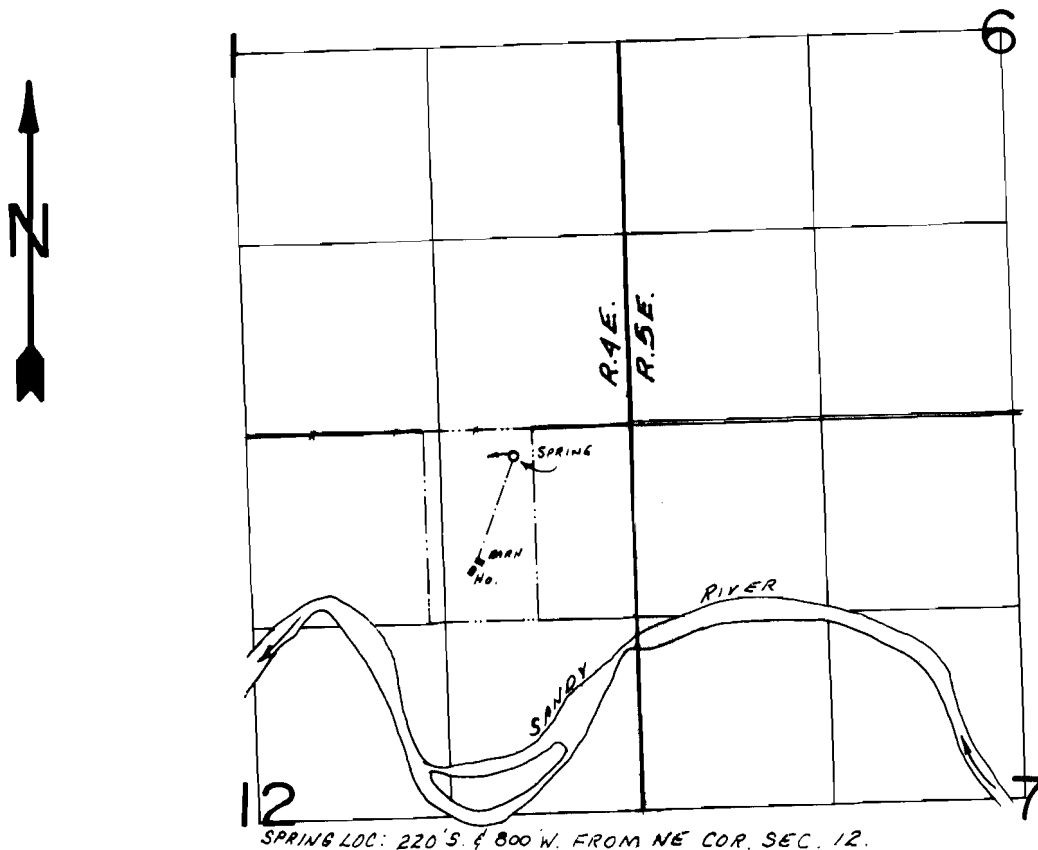

FINAL PROOF SURVEY
UNDER

Application No. 56070... Permit No. 41646.....
IN NAME OF

.....ERIC S. ERICKSON.....

Surveyed Sept. 20... 1984., by B.W. BISHOP.....