


T. 6N., R. 2W., W.M.

22

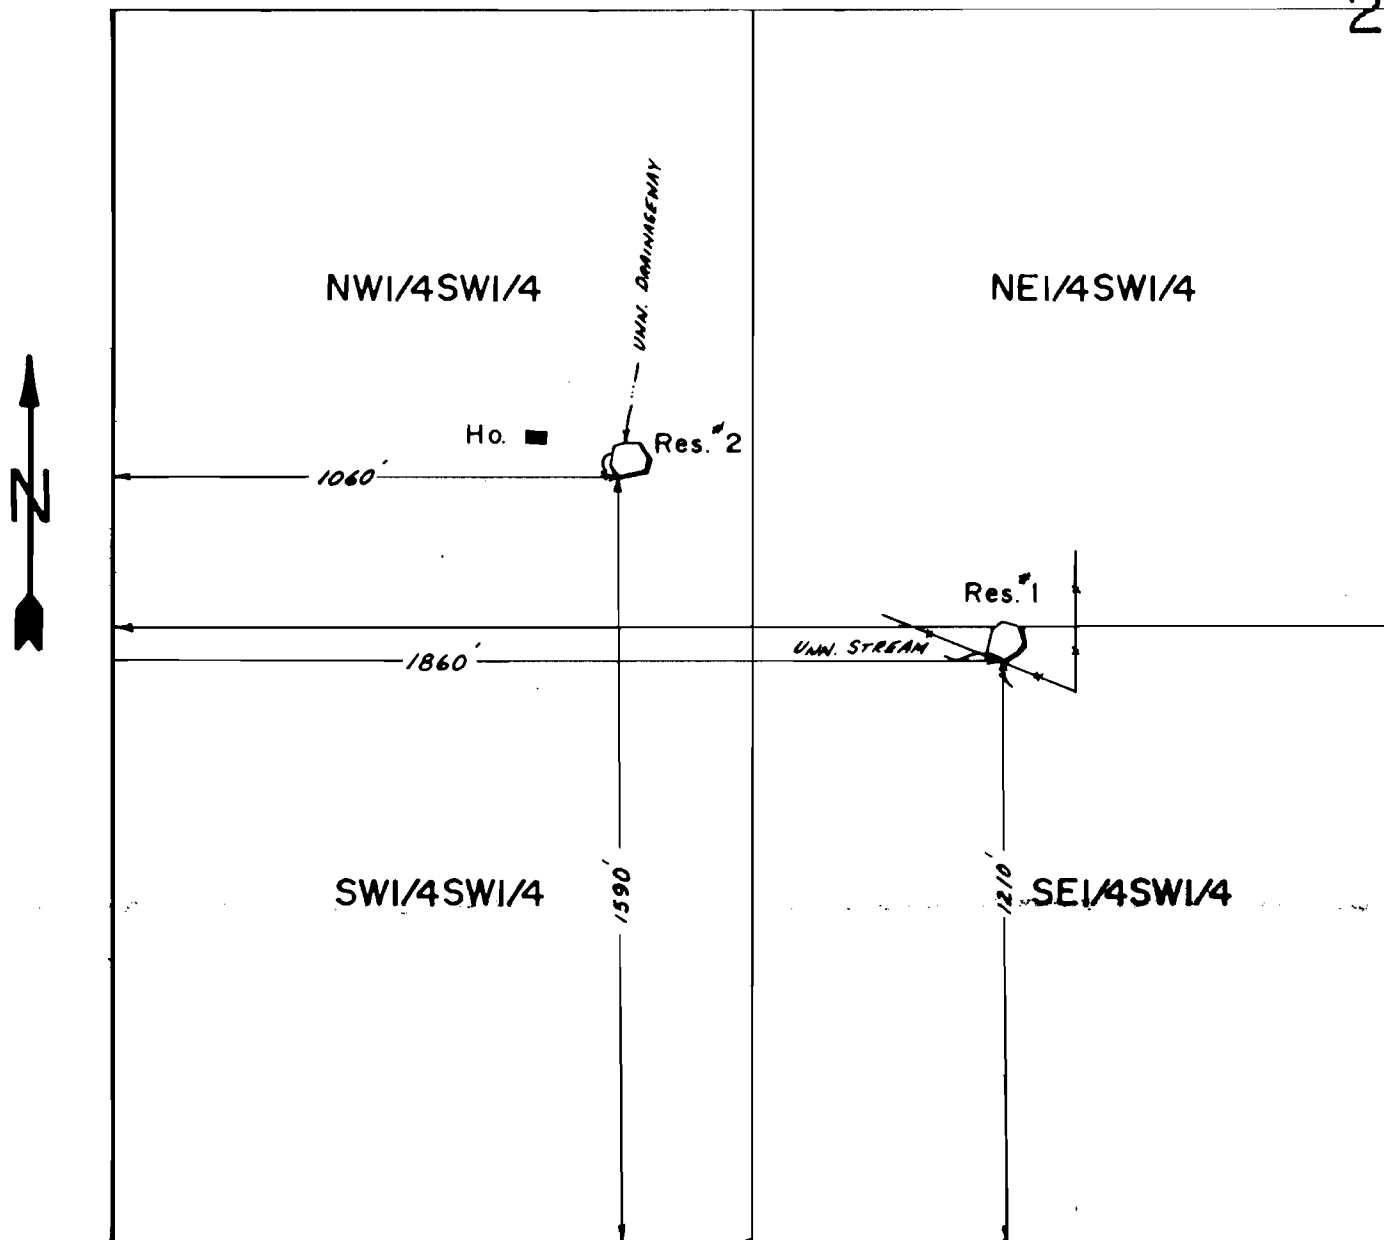

SCALE: 1"=400'

FINAL PROOF SURVEY
UNDER

R-63333

R-8412

Application No. 63333.4. Permit No. 46720.....

IN NAME OF

JAMES RYBURN, JR.

Surveyed May 24, 1984, by B.W. BISHOP.....