


T.28 S., R.13 W., W.M.

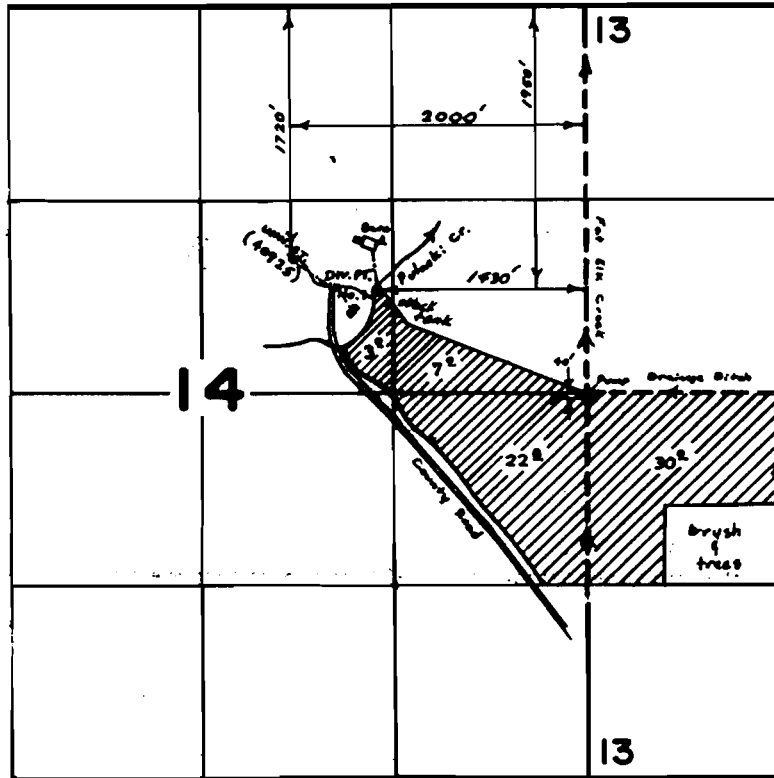

SCALE 4"=1 mile

FINAL PROOF SURVEY UNDER

54269 40924
Application No. 54270. Permit No. 40925.
IN NAME OF

.....ALBERT G. WOOSLEY.....

Surveyed August 9, 1978, by Del. Sparks...