


T.29S. R.6W. W.M.

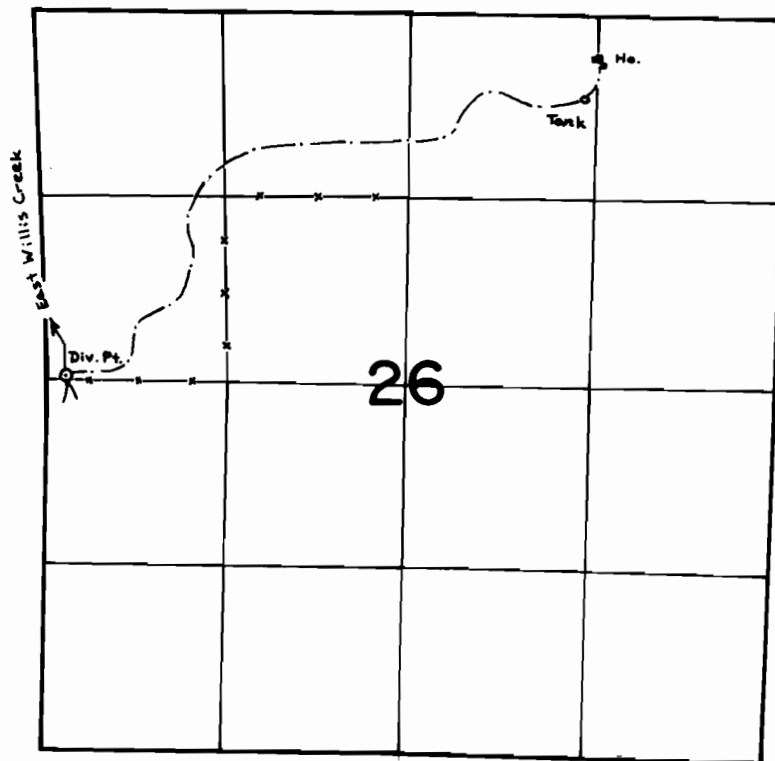

Div. Pt. Located: 30' N & 120' E from W 1/4 Sec. 26

SCALE: 4" = 1 mile

**FINAL PROOF SURVEY**  
UNDER

Application No. 54844 Permit No. 41368  
IN NAME OF

NOVA BATES COCKERAM

Surveyed April 4, 1979, by S. Donaldson