


T.28S., R.7W., W.M.

SEC.35

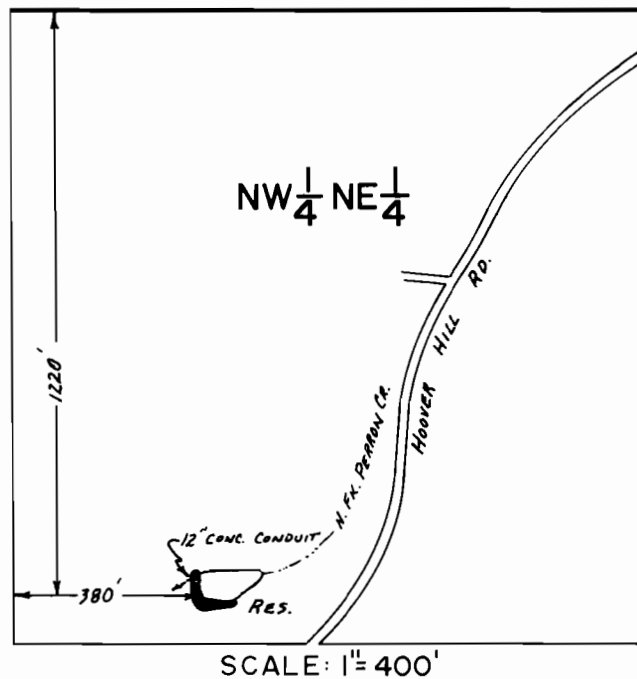

FINAL PROOF SURVEY
UNDER

Application No. R-50837 Permit No. R-6190.....
IN NAME OF

DAVID G., JR. & SHARON K. PERRON

Surveyed JUNE 6, 1979, by J. S. DONALDSON