


T. 2N., R. 20E., W. M.

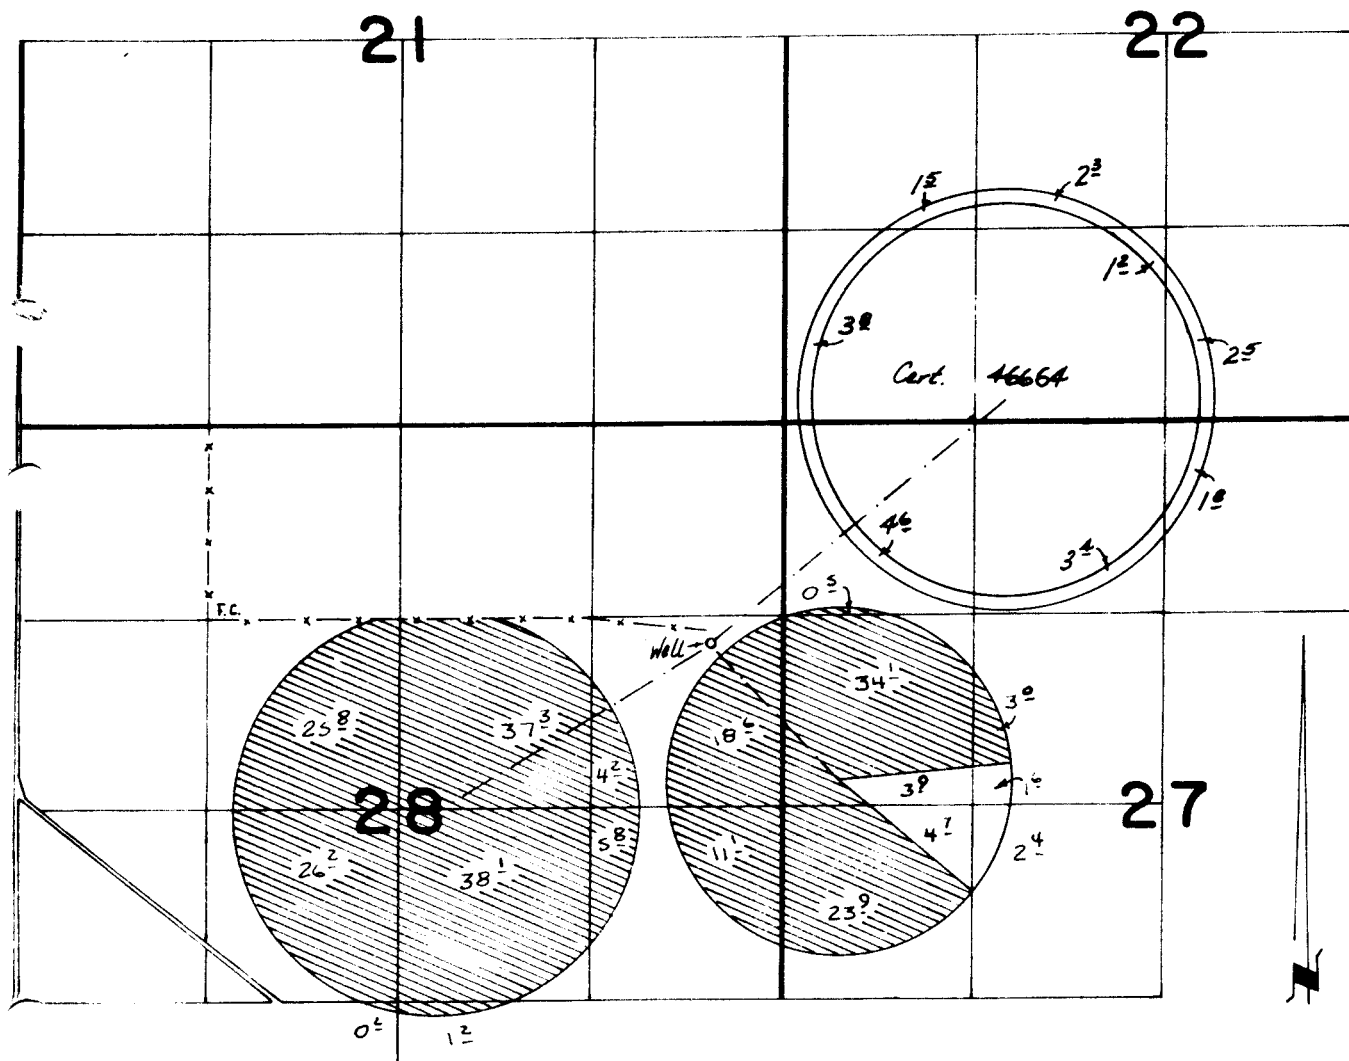

WELL LOC. - 1500' S. & 500' W. FROM N.E. COR. SEC. 28

SCALE: 1" = 1320'

FINAL PROOF SURVEY UNDER

Application No. **G:9670** Permit No. **G:8847**
IN NAME OF

STONE MACHINERY CO., INC.

Surveyed **5:8** 19**85**, by **V.L. Cheren**