


P-34842

C-53439

T. 12S. R. 27E. W. M.

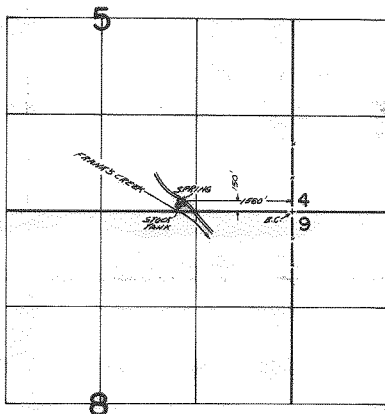

FINAL PROOF SURVEY
UNDER

Application No. **46628** Permit No. **34842**.....
IN NAME OF

.....**CLIFTON MACKAY**.....

Surveyed Sept. 16, 1979, by **S.C. BROWN**.....