


T. 34 S., R. 1 W., W.M.
SEC. 16

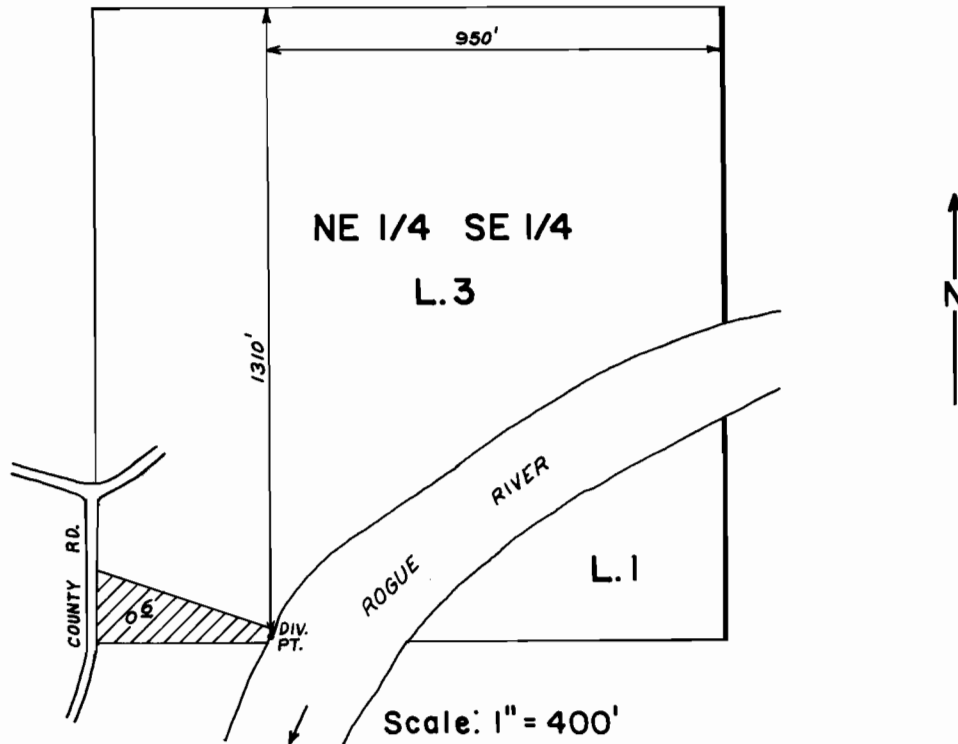

FINAL PROOF SURVEY
UNDER

Application No. **53211**..... Permit No. **39485**.....
IN NAME OF

HARTVIG E. &/OR GLADYS R. NELSON

Surveyed **NOV. 4** 19**82**, by **B. S. JAMES**.....