


T. 13 S., R. 9 E., W.M.

SECTION 10

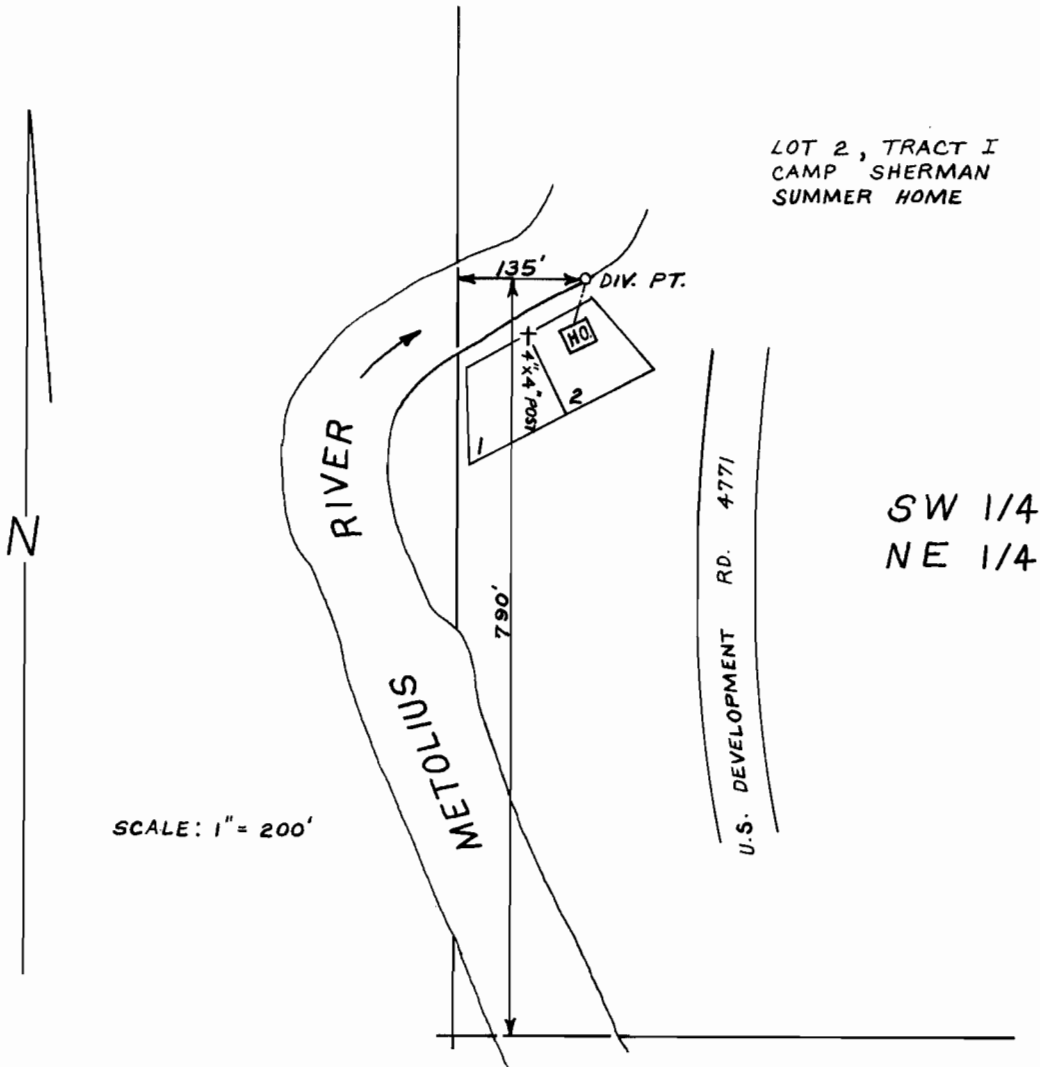

SCALE: 1" = 200'

FINAL PROOF SURVEY

UNDER

Application No. 65385 Permit No. 47702

IN NAME OF

DONALD R. WILES

Surveyed MAY 1, 19 85, by LESLIE OLSON.