


T 13 S., R. 9 E., W.M.
SECTION 15

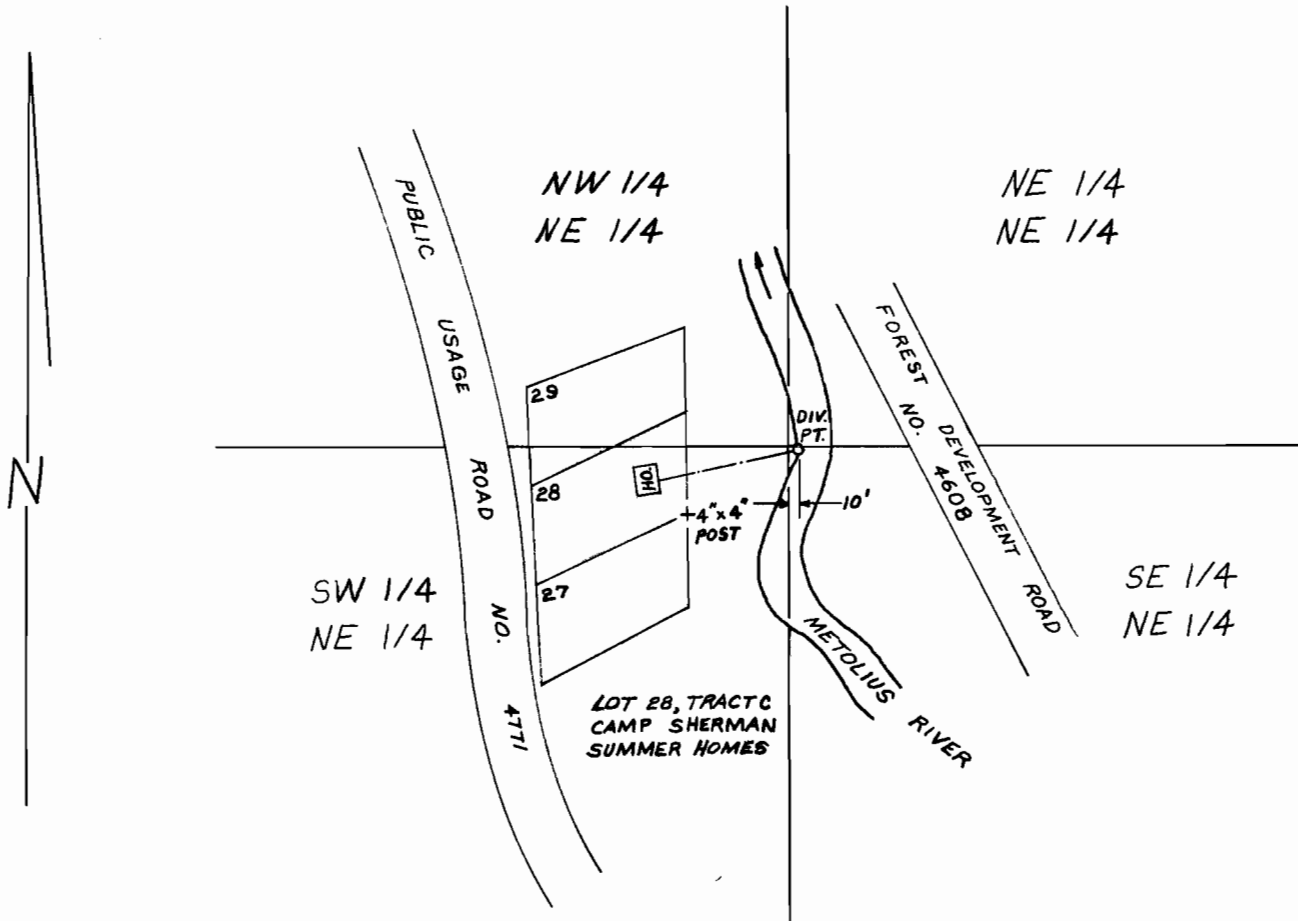

SCALE: 1" = 200'

FINAL PROOF SURVEY
UNDER

Application No. 65097 Permit No. 47816

IN NAME OF

R. VERNE CASEY

Surveyed APRIL 3, 1985, by LESLIE OLSON