


T. 13 S., R. 9 E., W.M.

SECTION 10

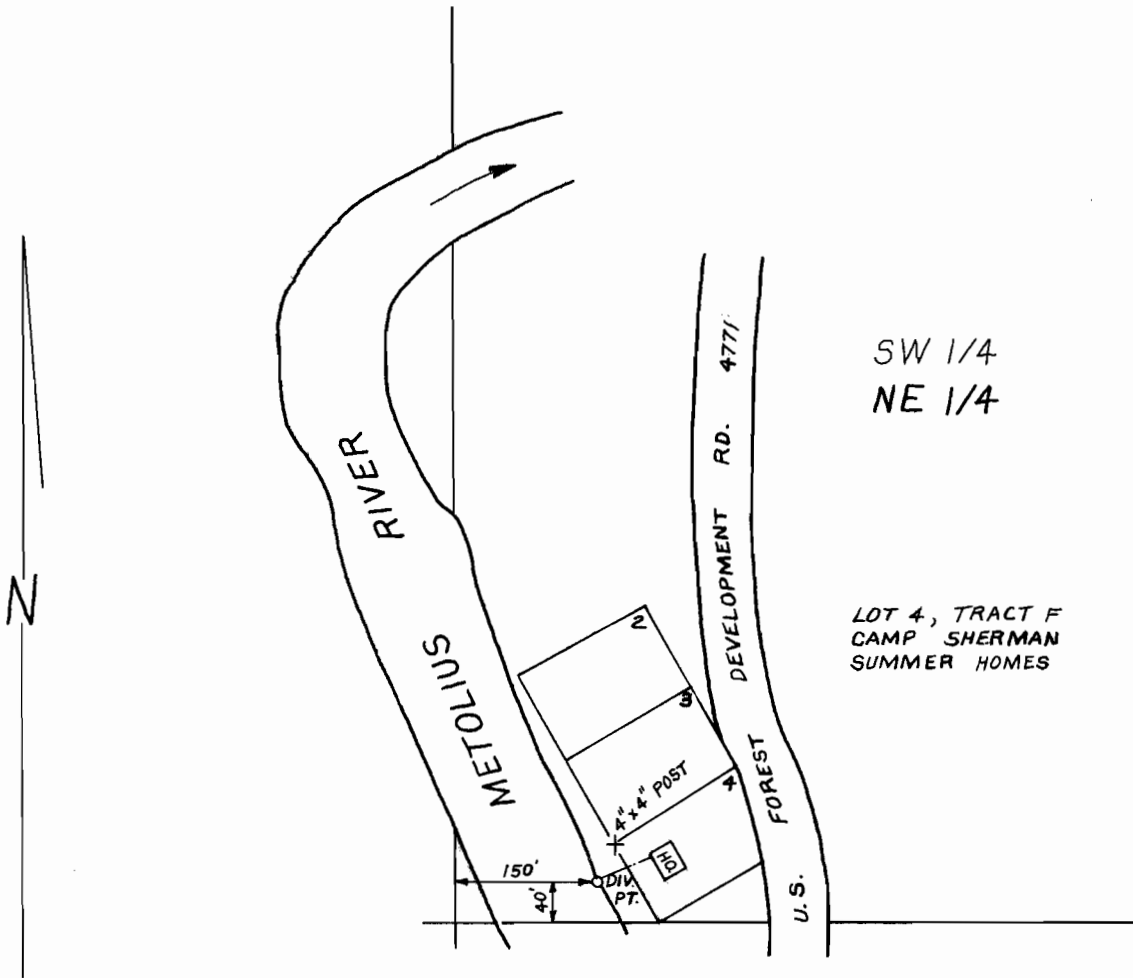

SW 1/4  
NE 1/4

LOT 4, TRACT F  
CAMP SHERMAN  
SUMMER HOMES

SCALE: 1" = 200'

FINAL PROOF SURVEY

UNDER

Application No. 65308 Permit No. 47922

IN NAME OF

LOUIS L. & REBECCA M. SCHNEIDER

Surveyed MAY 1, 19 85, by LESLIE OLSON