


T. 13 S., R. 9 E., W.M.
SECTION 15

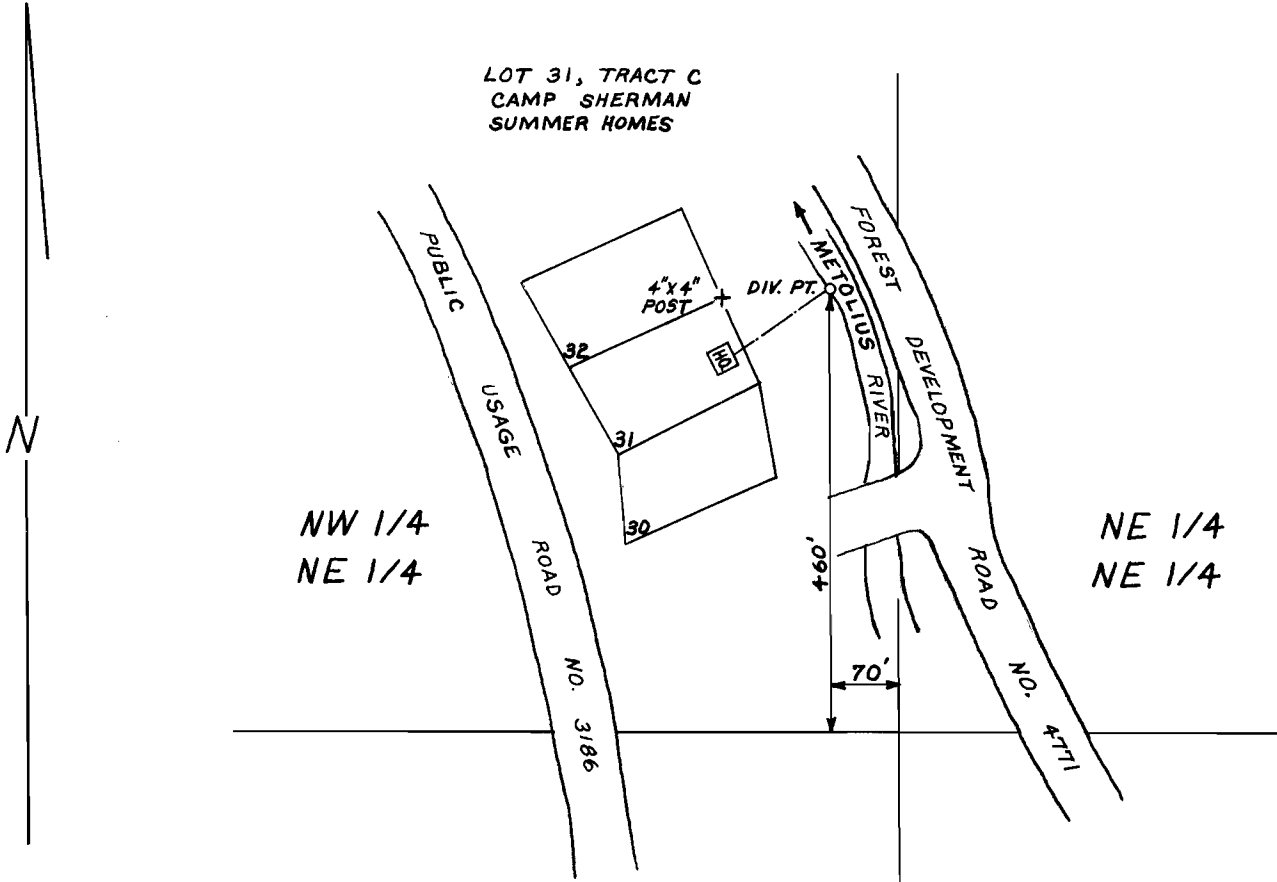

SCALE: 1" = 200'

FINAL PROOF SURVEY
UNDER

Application No. 65318 Permit No. 47926

IN NAME OF

EDMOND F. FIENE

Surveyed APRIL 3 19 85, by LESLIE OLSON