


T. 13S., R. 9E., W.M.
SECTION 15

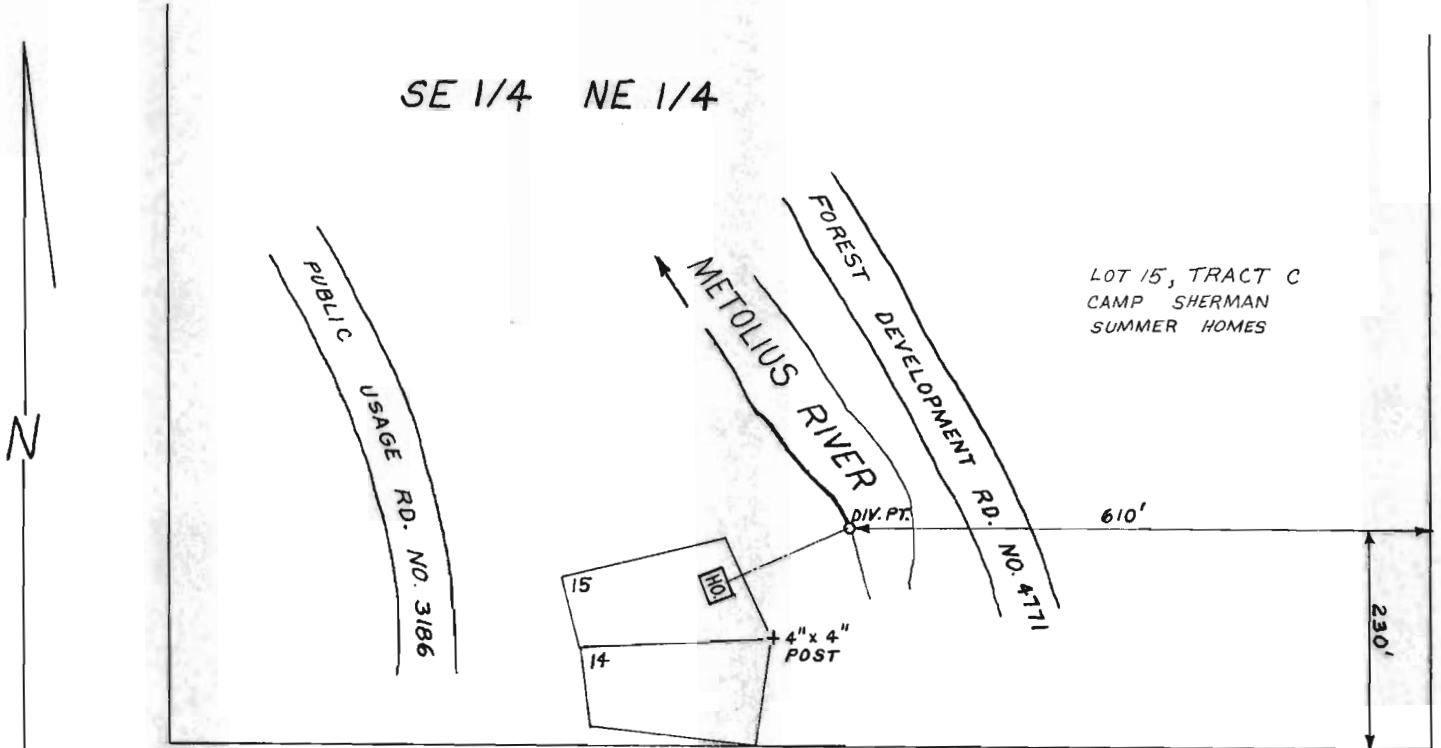

SCALE: 1" = 200'

FINAL PROOF SURVEY

UNDER

Application No. 65383 Permit No. 47949

IN NAME OF

DENNIS E. & ESTELLE McCAFFERTY

Surveyed APRIL 3, 1985, by LESLIE OLSON