


T. 13 S., R. 9 E., W.M.

SECTION 15

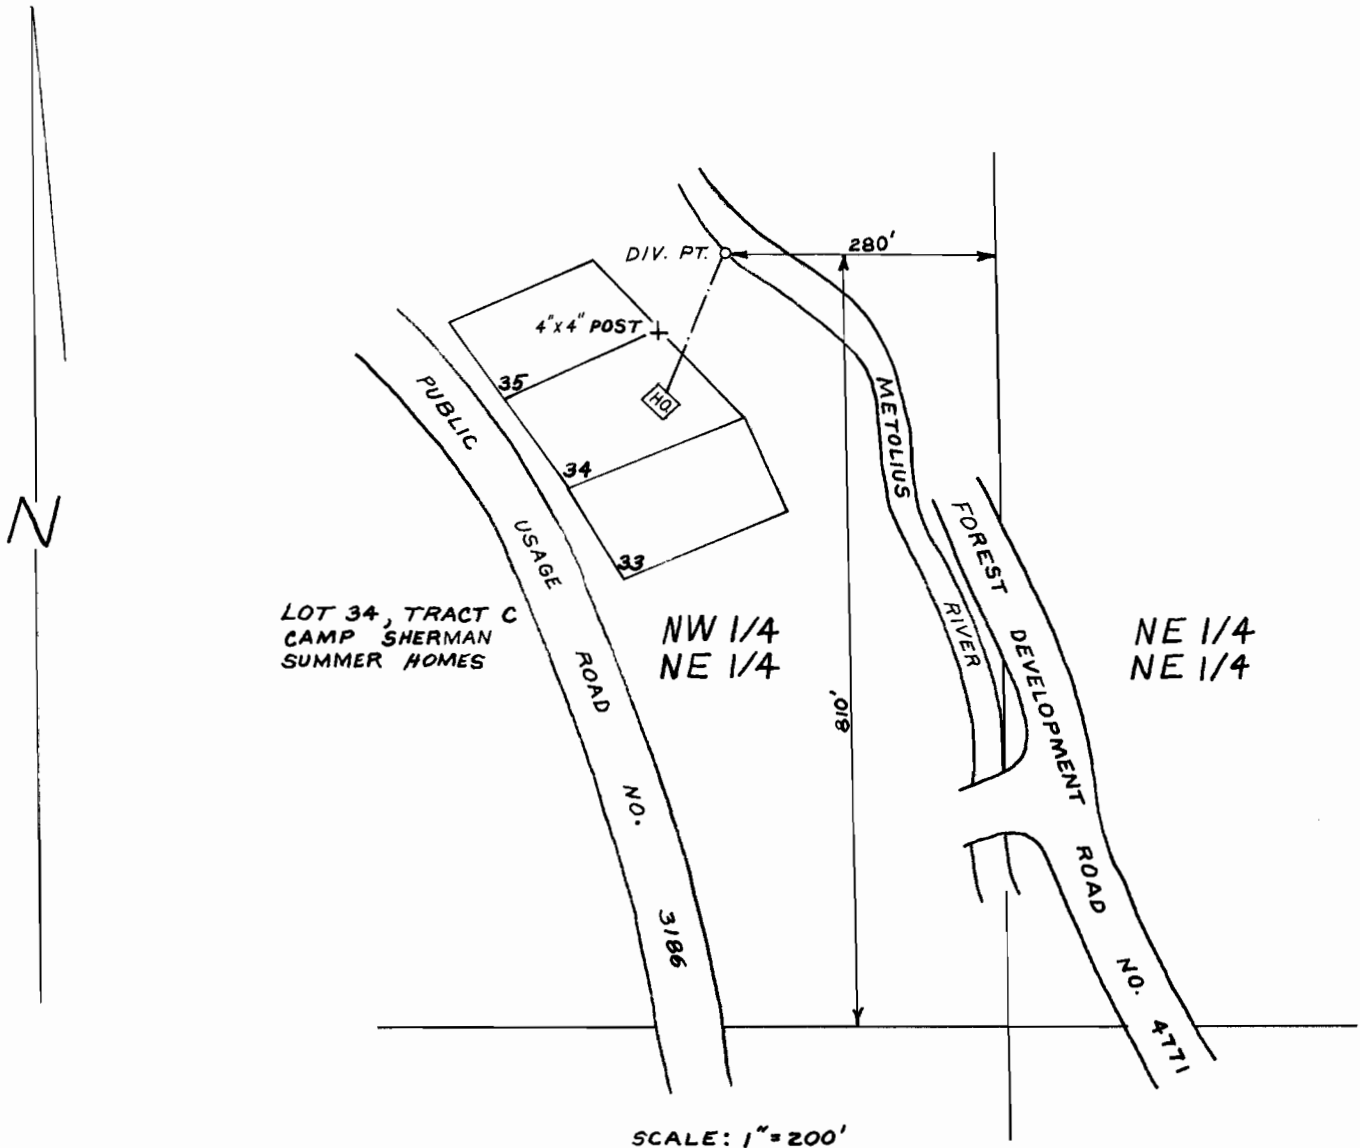

FINAL PROOF SURVEY

UNDER

Application No. 65467 Permit No. 47955

IN NAME OF

HENRY R. FAILING

Surveyed FEB. 28. 19. 85., by LESLIE OLSON