


T. 13 S., R. 9 E., W. M.

SECTION 10

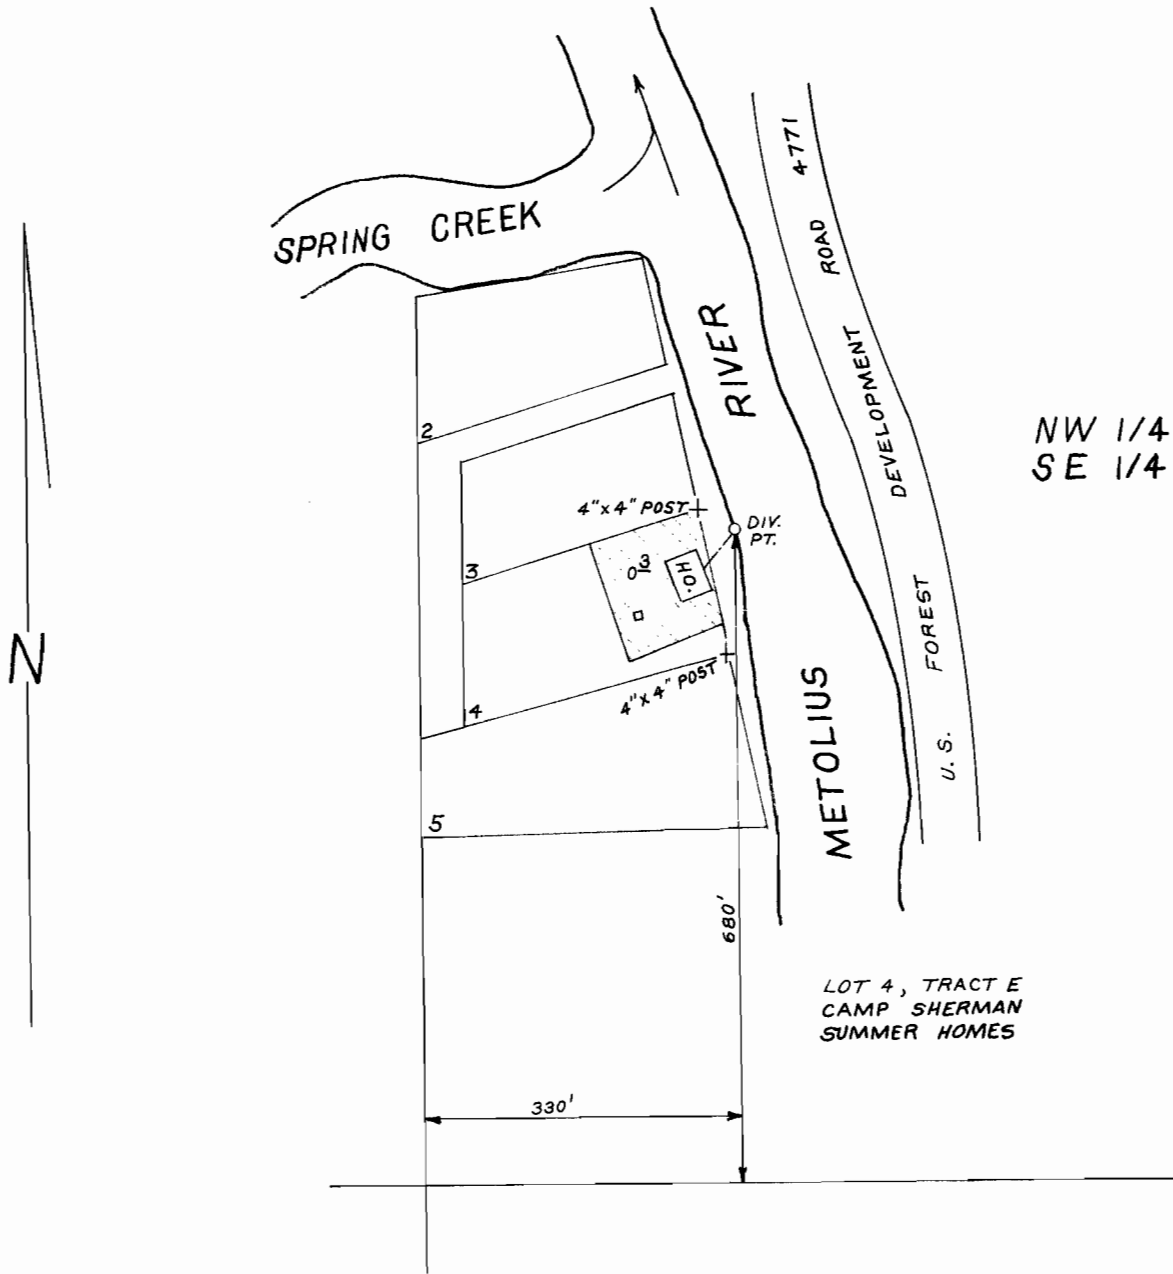

SCALE: 1" = 200'

# FINAL PROOF SURVEY

UNDER

Application No. 65478 Permit No. 47960.....

IN NAME OF

ERNEST TUCKER LIVINGSTONE

Surveyed MAY 1, 1985, by TIM W. BURKS