


T.26S.,R.18E.,W.M.

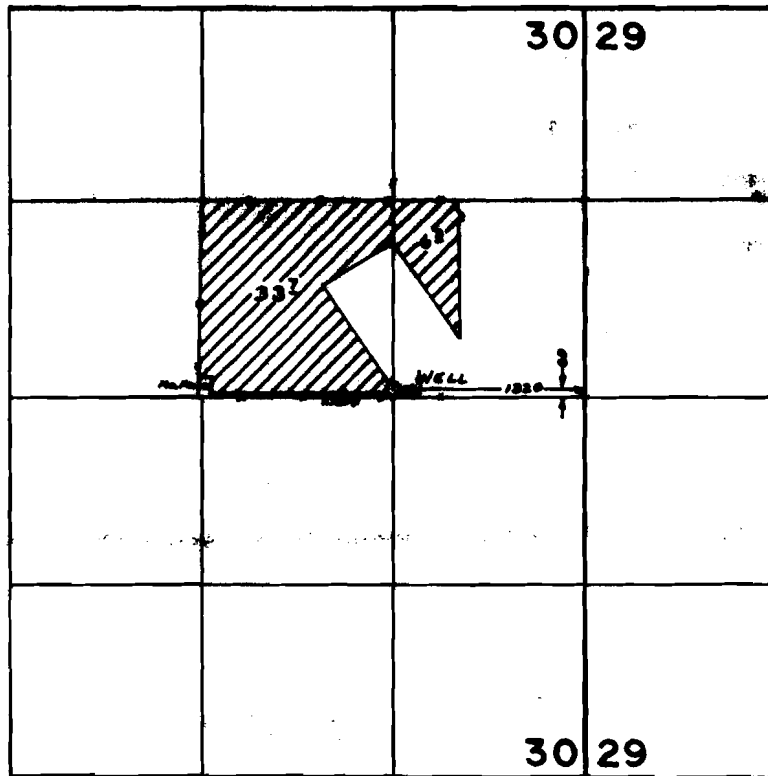

FINAL PROOF SURVEY UNDER

Application No. G-8205 Permit No. G-8245
IN NAME OF

KENYON K. MOREHOUSE

Surveyed OCT. 23. 1981., by L. TOLL