


# T.26S.,R.18E.,W.M.

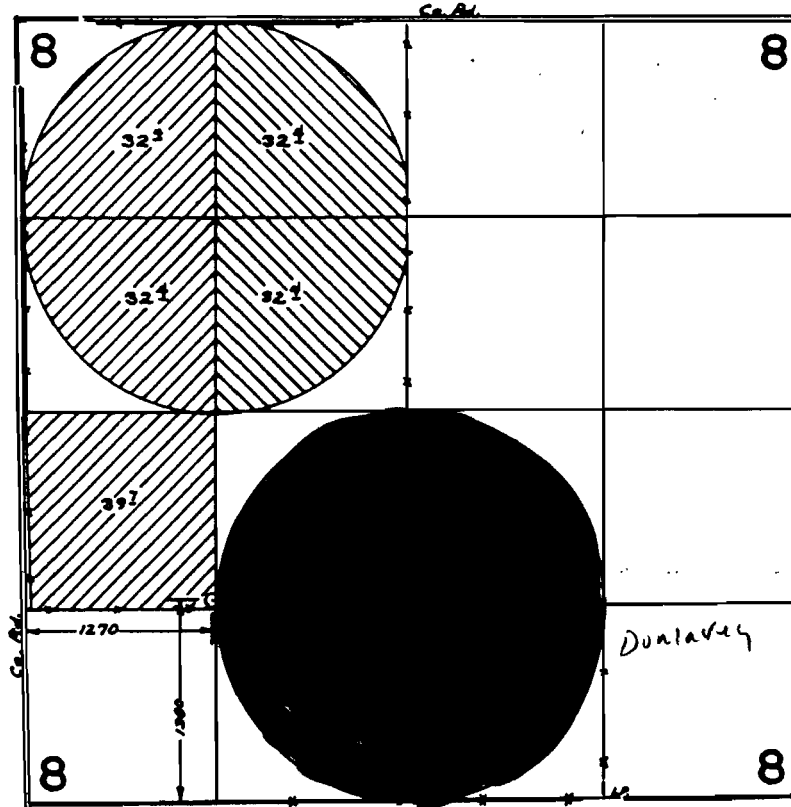

## FINAL PROOF SURVEY UNDER

Application No. G-9792 G-8876  
G-10173 Permit No. G-9233

IN NAME OF

FRED G. CROUCH

[Redacted], by ...L...TOLL.....