


G.9118 12  
53456  
75532  
T6864  
T8420

T.27S., R.17E., W.M.

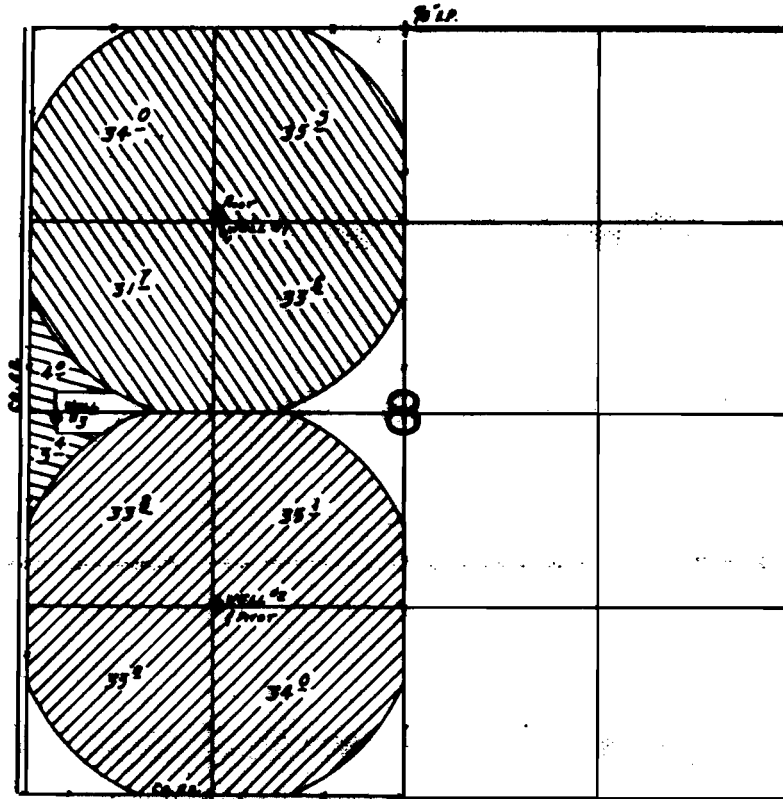

SCALE: 1"=1320'

WELLS LOC: #1-1820'S. / 1880' W., #2-3950'S. / 1310' W., #3-2670'S.  
/ 2410' W., ALL FROM N 1/4 COR. SEC. 8.

 WELL No.1       WELL No.3  
 WELL No.2

### FINAL PROOF SURVEY UNDER

Application No. G:9836. Permit No. G:9118.....  
IN NAME OF

.....CHARLES D. NOFZIGER.....

Surveyed OCT. 28. 1964., by B.W. BISHOP.....