


G-9408 12
53460

RECEIVED

SEP 03 1985

WATER RESOURCES DEPT
SALEM, OREGON

T.27S.,R.19E.,W.M.

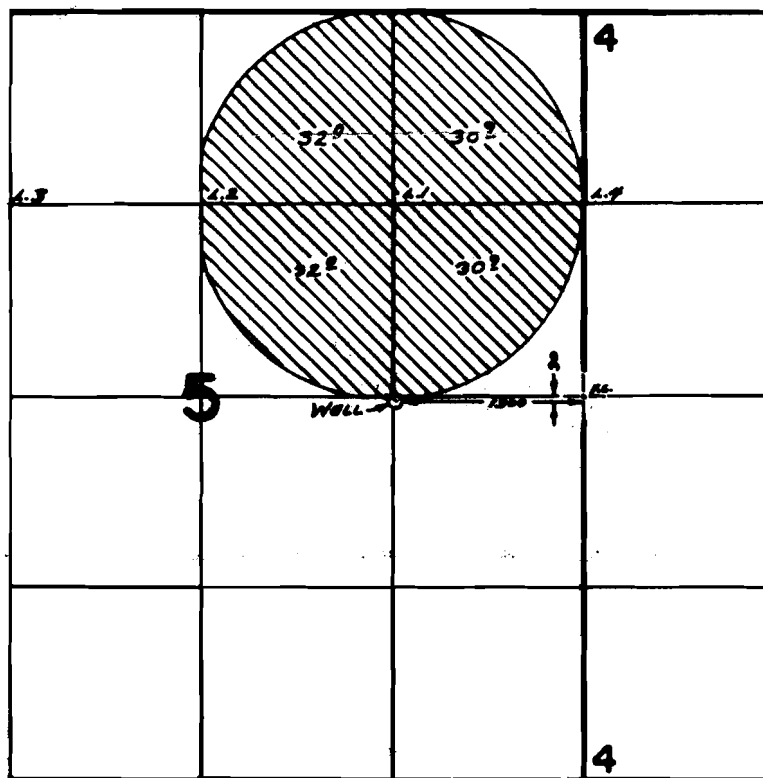

FINAL PROOF SURVEY
UNDER

Application No. G-10219 Permit No. G-9408
IN NAME OF

HARLAN FRANK OSTER

Surveyed OCT. 22 1981, by J. TOLL