


T. 8S., R. 11W., W.M.

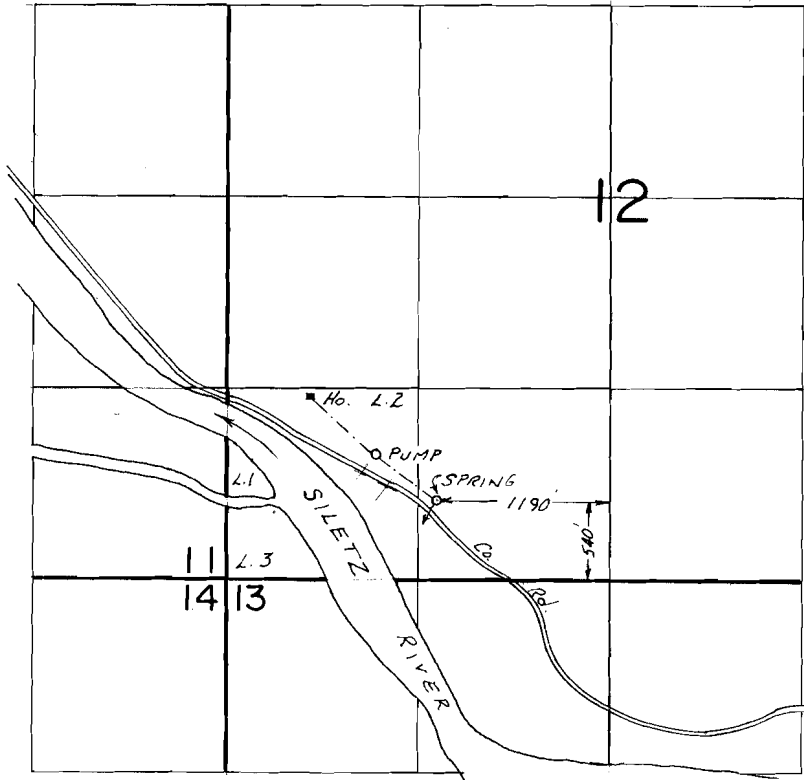

SCALE: 1" = 1320'

FINAL PROOF SURVEY
UNDER

Application No. 61262.. Permit No. 45623.....
IN NAME OF

.....LEWIS H. LUNDSTEDT.....

Surveyed Sept. 12.... 19.84, by B.W. BISHOP.....