


T.11S. R.3W. W.M.

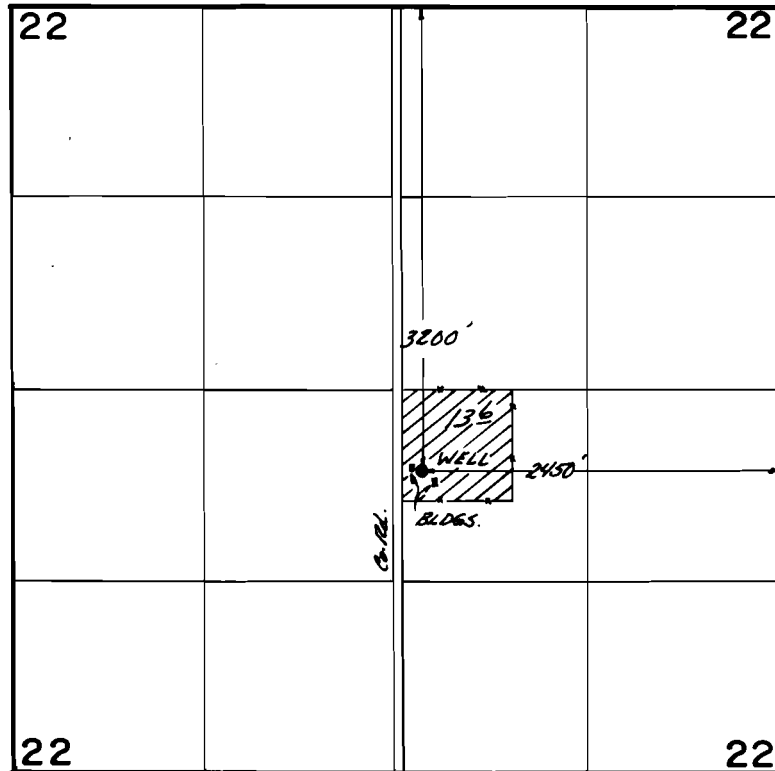

FINAL PROOF SURVEY
UNDER

Application No. G-5698 Permit No. G-5507....
IN NAME OF

.....WILMER M. LIECHTY.....

Surveyed April 24 1979., by S.C.BROWN.....