# T.8S. R.2W., W.M.

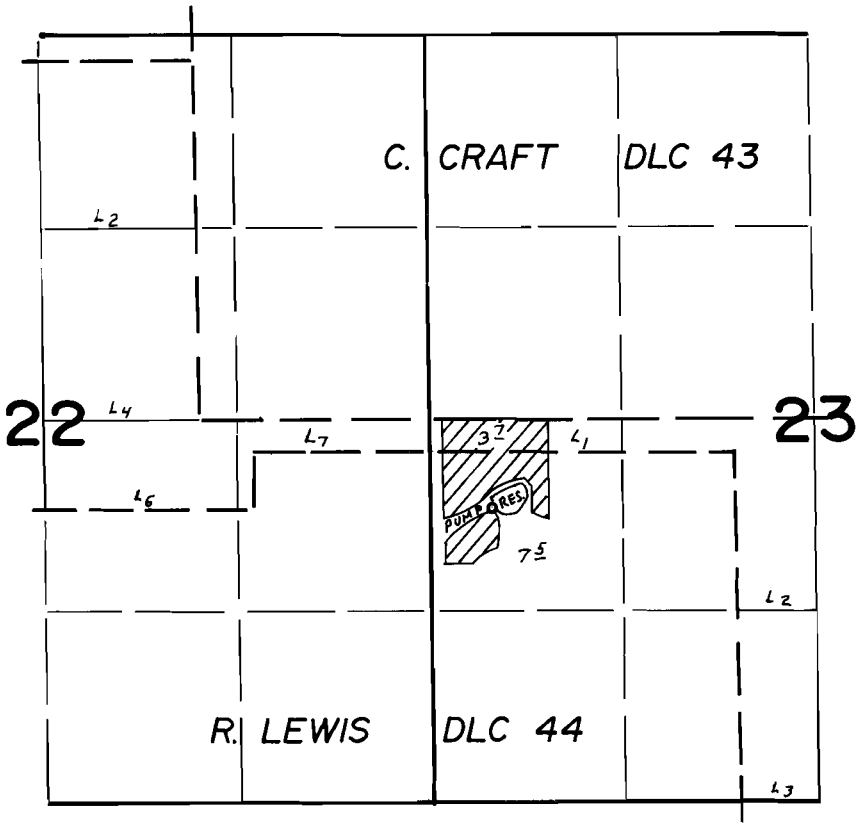


PUMP LOC. 610'S. & 420' E. FROM W. 1/4 COR. SEC. 23

# FINAL PROOF SURVEY

UNDER

Application No. R-51720 (51311) Permit No. R-6216 (38742)

IN NAME OF

THOMAS WILLIAM FRY

Surveyed JUNE 8 1979, by L. H. NUNN

DFN-311-52