


T.8S. R.2W., W.M.

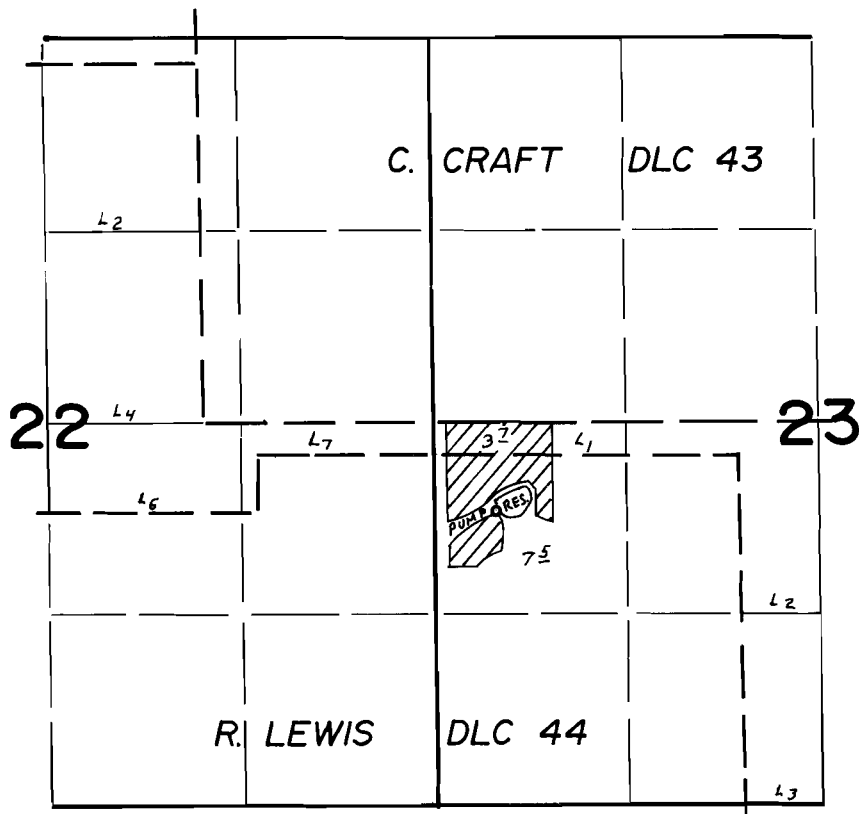

Pump Loc. 610'S. & 420' E. From W. 1/4 Cor. Sec. 23

FINAL PROOF SURVEY UNDER

51311 38742
Application No. R-51720 Permit No. R-6216.....
IN NAME OF

.....THOMAS WILLIAM FRY.....

Surveyed JUNE 8... 1979., by L.H. NUNN.....