


T. 4 S., R. 1 W., W.M.

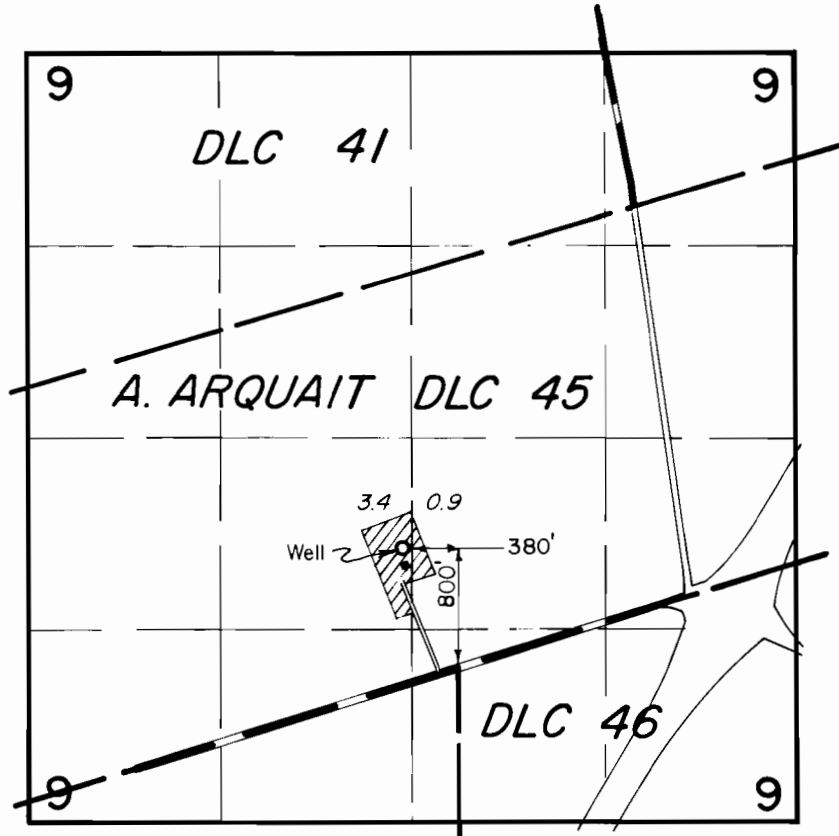

FINAL PROOF SURVEY UNDER

Application No. G-6369 Permit No. G-5189

IN NAME OF

R. LARRY ROWSE

Surveyed AUG. 29, 1979, by *ABM*