


T.9S.,R.3E.,W.M.

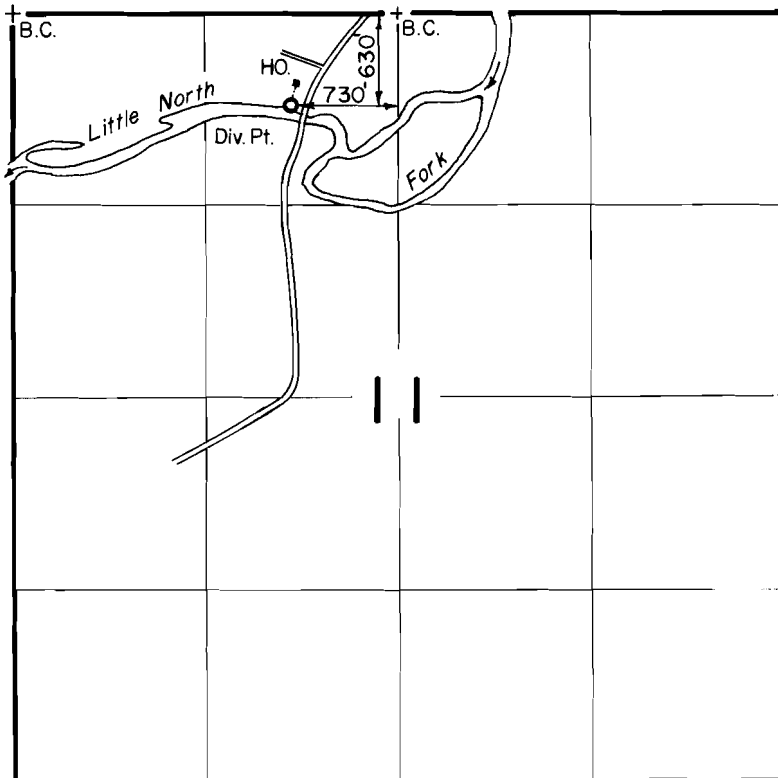

FINAL PROOF SURVEY UNDER

Application No. 50294. Permit No. 37973.....

IN NAME OF

Vern L. & Shirley M. Vogel

Surveyed AUG. 23, 1979, by *dlB...*