


T.4S. R.2W. WM.

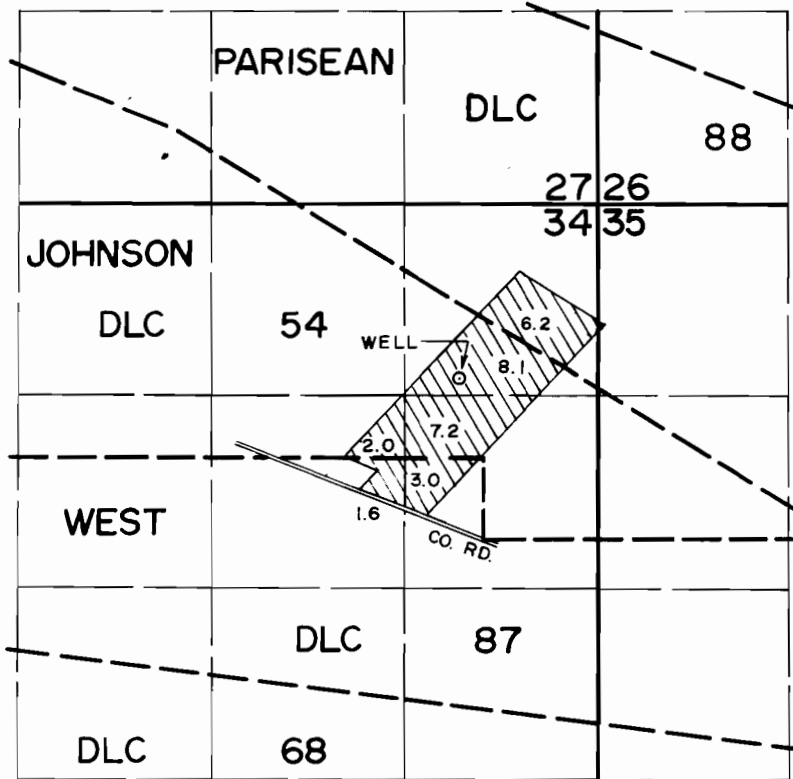

WELL LOCATION: 1100 FT. N. AND 170 FT. W. FROM S.W. CORNER OF DLC 54.

FINAL PROOF SURVEY UNDER

Application No. ~~G-8785~~ Permit No. ~~G-8087~~.....
IN NAME OF

.....FADEY FROLOV.....

Surveyed July 10, 1980, by C.L. Hughes.....