


G-7210
53472

T. 2S., R. 26E., W.M.

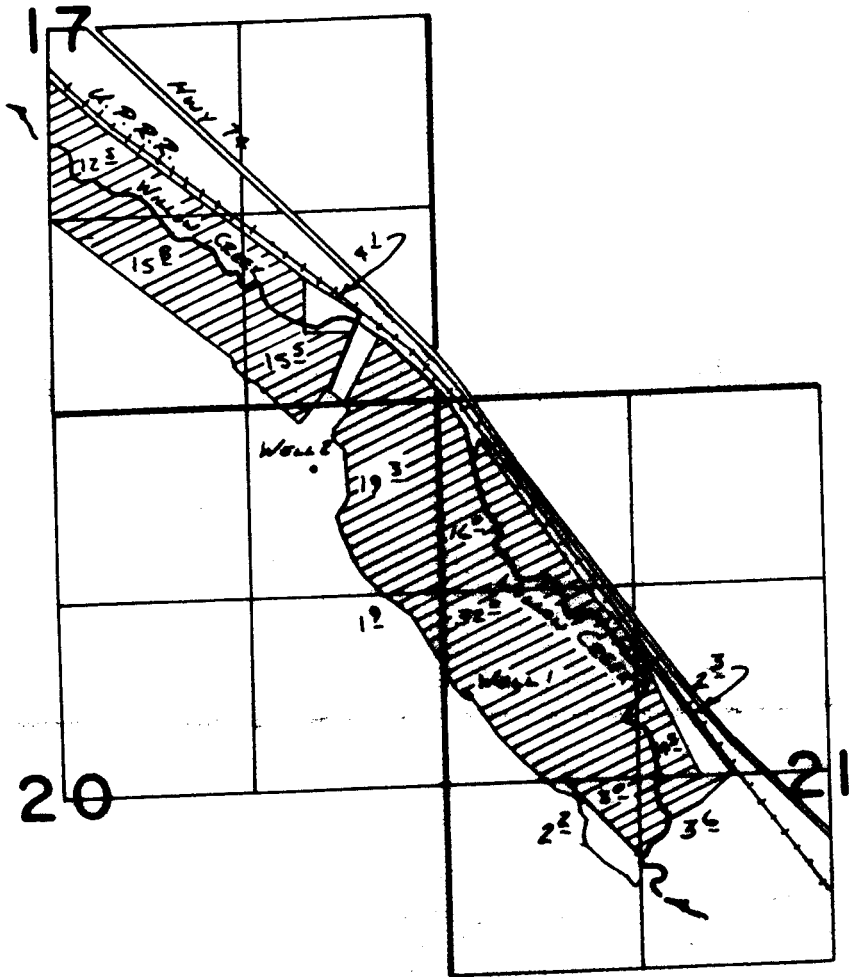

Well 1 loc: 2040'S. ± 180'E. From NW Cor. Sec. 21
 Well 2 loc: 440'S ± 870'W. From NE Cor. Sec. 20

FINAL PROOF SURVEY
 UNDER

G-8149 G-7210
 Application No. G-5912 Permit No. G-7211
 IN NAME OF

ANNA GRAHAM

Surveyed Oct. 11, 1982, by K.H. Church

Well 2
 Well 1 → remove, if
 for G-7211 cancelled