


T. 2S., R. 28E., W.M.

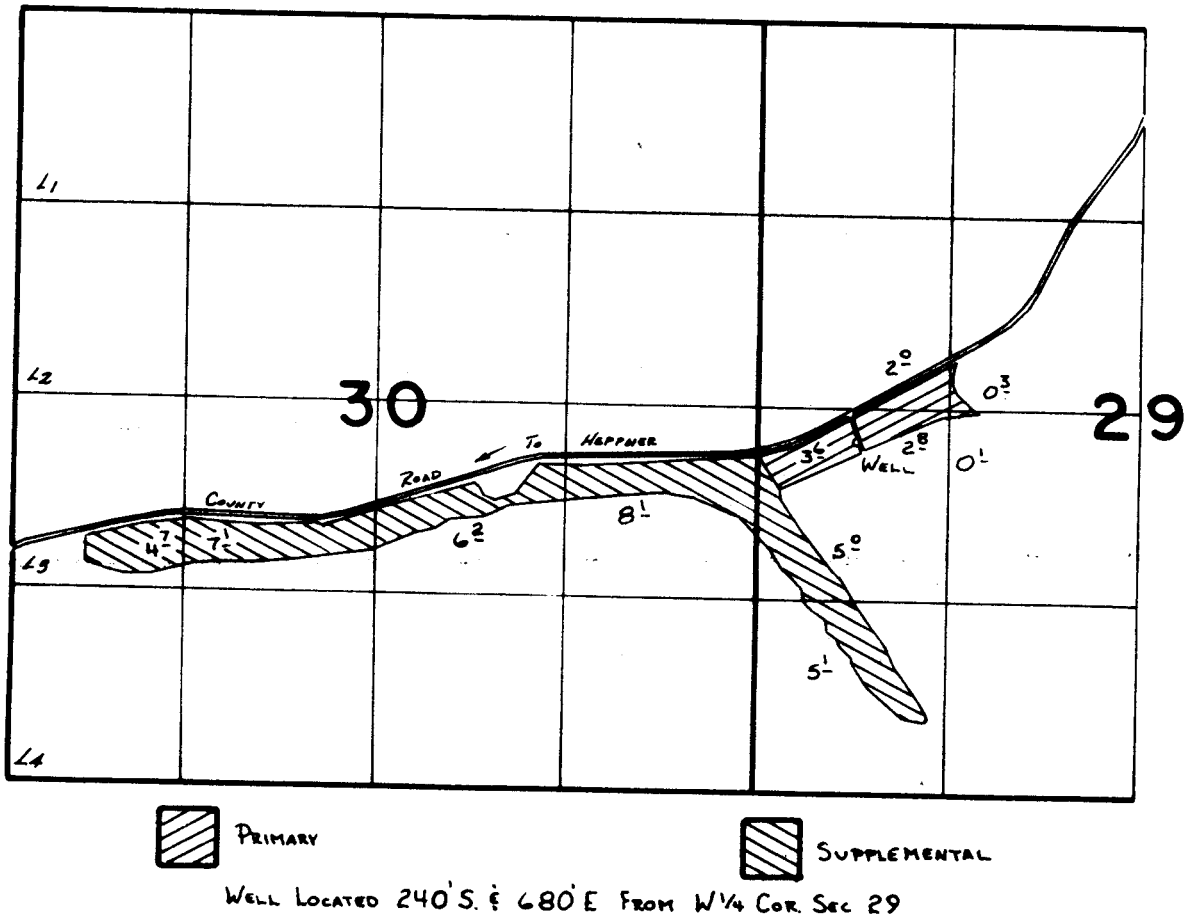

FINAL PROOF SURVEY

UNDER

Application No. **G:6837**. Permit No. **G:6380**...
IN NAME OF

.....DON GREENUP.....

Surveyed 7-14 1983, by Y. h. Church

SCALE: 1"=1320'